 


PSM105139
 E: 494.333.800
 N: 7056051.090
 RL: 68.200m

UNITYWATER PROJECT NUMBER 2018012467S0

41 GLENBROOK DRIVE, NAMBOUR

AS CONSTRUCTED SEWER & WATER



DRAWING INDEX	
DRAWING NUMBER	DESCRIPTION
U-2022-4398-1	LOCALITY PLAN AND DRAWING INDEX
U-2022-4398-2	AS CONSTRUCTED SEWER SHEET 1
U-2022-4398-3	AS CONSTRUCTED SEWER SHEET 2
U-2022-4398-4	AS CONSTRUCTED SEWER SHEET 3
U-2022-4398-5	AS CONSTRUCTED SEWER SHEET 4
U-2022-4398-6	AS CONSTRUCTED SEWER SHEET 5
U-2022-4398-7	AS CONSTRUCTED SEWER SHEET 6
U-2022-4398-8	AS CONSTRUCTED SEWER SHEET 7
U-2022-4398-9	AS CONSTRUCTED WATER SHEET 1
U-2022-4398-10	AS CONSTRUCTED WATER SHEET 2
U-2022-4398-11	AS CONSTRUCTED WATER SHEET 3
U-2022-4398-12	AS CONSTRUCTED WATER SHEET 4
U-2022-4398-13	AS CONSTRUCTED WATER SHEET 5
U-2022-4398-14	AS CONSTRUCTED WATER SHEET 6

ENGINEER'S CERTIFICATION

I, _____, hereby certify that:

- The information contained in this drawing / document is in compliance with approved drawings and design.
- The new water and sewerage works defined by this drawing have been designed and constructed in accordance with the SEQ Code.
- This represents an accurate record of as-constructed works.
- I accept responsibility for the information contained in this drawing / document.

 RPEQ (signature) RPEQ No. _____ Date: _____

REGISTERED SURVEYOR'S CERTIFICATION




I, DTS Group Old Pty Ltd, hereby certify that the vertical and horizontal locations and dimensions shown on this plan are a true and correct record and were located by survey.


[Signature]
 Registered Surveyor (sig.) Reg. Surveyor No. 3115 Date: 19-02-2024

COORDINATE DATUM NOTE:
 HORIZONTAL COORDINATES(E,N) SUPPLIED ARE MAPPING GRID OF AUSTRALIA(MGA), ZONE 56 BASED ON THE UNIVERSAL TRANSVERSE MERCATOR PROJECTION AND THE GEOCENTRIC DATUM OF AUSTRALIA 2020.



AS CONSTRUCTED

A1	INDEX	DATE	REVISIONS	DRAWN	CHECKED	PASSED	DRAWN	CHECKED	PASSED	INITIALS	DATE	 Brisbane Machay PO Box 3126, West End QLD 4101 PO Box 11711, Mackay Queensland QLD 4740 Ph: 07 3118 0600 Ph: 0800 278 788 brisbane@dtsdtd.com.au machay@dtsdtd.com.au	 	Unitywater 2018012467S0 STAGES 1-4 41 GLENBROOK DRIVE, NAMBOUR COVER SHEET	SHEET 1 OF 14 SHEETS	SCALE 1:1500
	A	19-02-2024	FINAL AS CONSTRUCTED	AA	SW										REVISION DATE 19-02-2024 REVISION A	DISCIPLINE CODE C

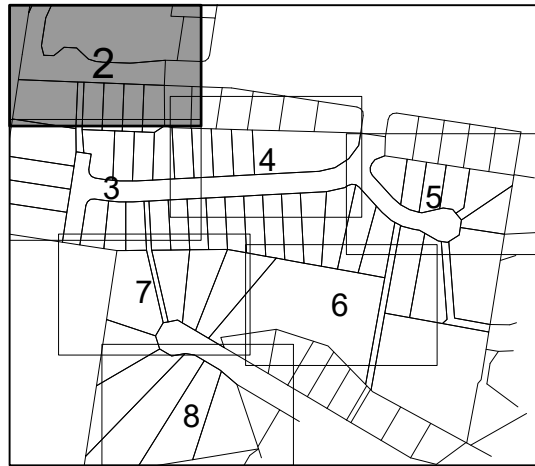

KEY MAP
Scale 1:3000


- All sewer lines are \varnothing 150 PVC, Class SN8 pipes unless noted otherwise.
- All manholes are \varnothing 1200, concrete, insitu unless noted otherwise.
- All manhole covers are Cast Iron, Circular and Class 'D' unless noted otherwise.
- Each allotment is serviced by a \varnothing 100 PVC HC unless noted otherwise.
- All bedding to pipes is Type '4' unless noted otherwise.
- Year of construction 2024.

ENGINEER'S CERTIFICATION
I, _____, hereby certify that:
1. The information contained in this drawing / document is in compliance with approved drawings and design.
2. The new water and sewerage works defined by this drawing have been designed and constructed in accordance with the SEQ Code.
3. This represents an accurate record of as-constructed works
4. I accept responsibility for the information contained in this drawing / document.
RPEQ (signature) RPEQ No. _____ Date: _____

REGISTERED SURVEYOR'S CERTIFICATION
DTS Group Old Pty Ltd _____ hereby certify that the vertical and horizontal locations and dimensions shown on this plan are a true and correct record and were located by survey.
Registered Surveyor (sig) _____ Reg. Surveyor No. 3115 Date: 19-02-2024


SP336371

PSM105139
E: 494.333.800
N: 7056051.090
RL: 68.200m

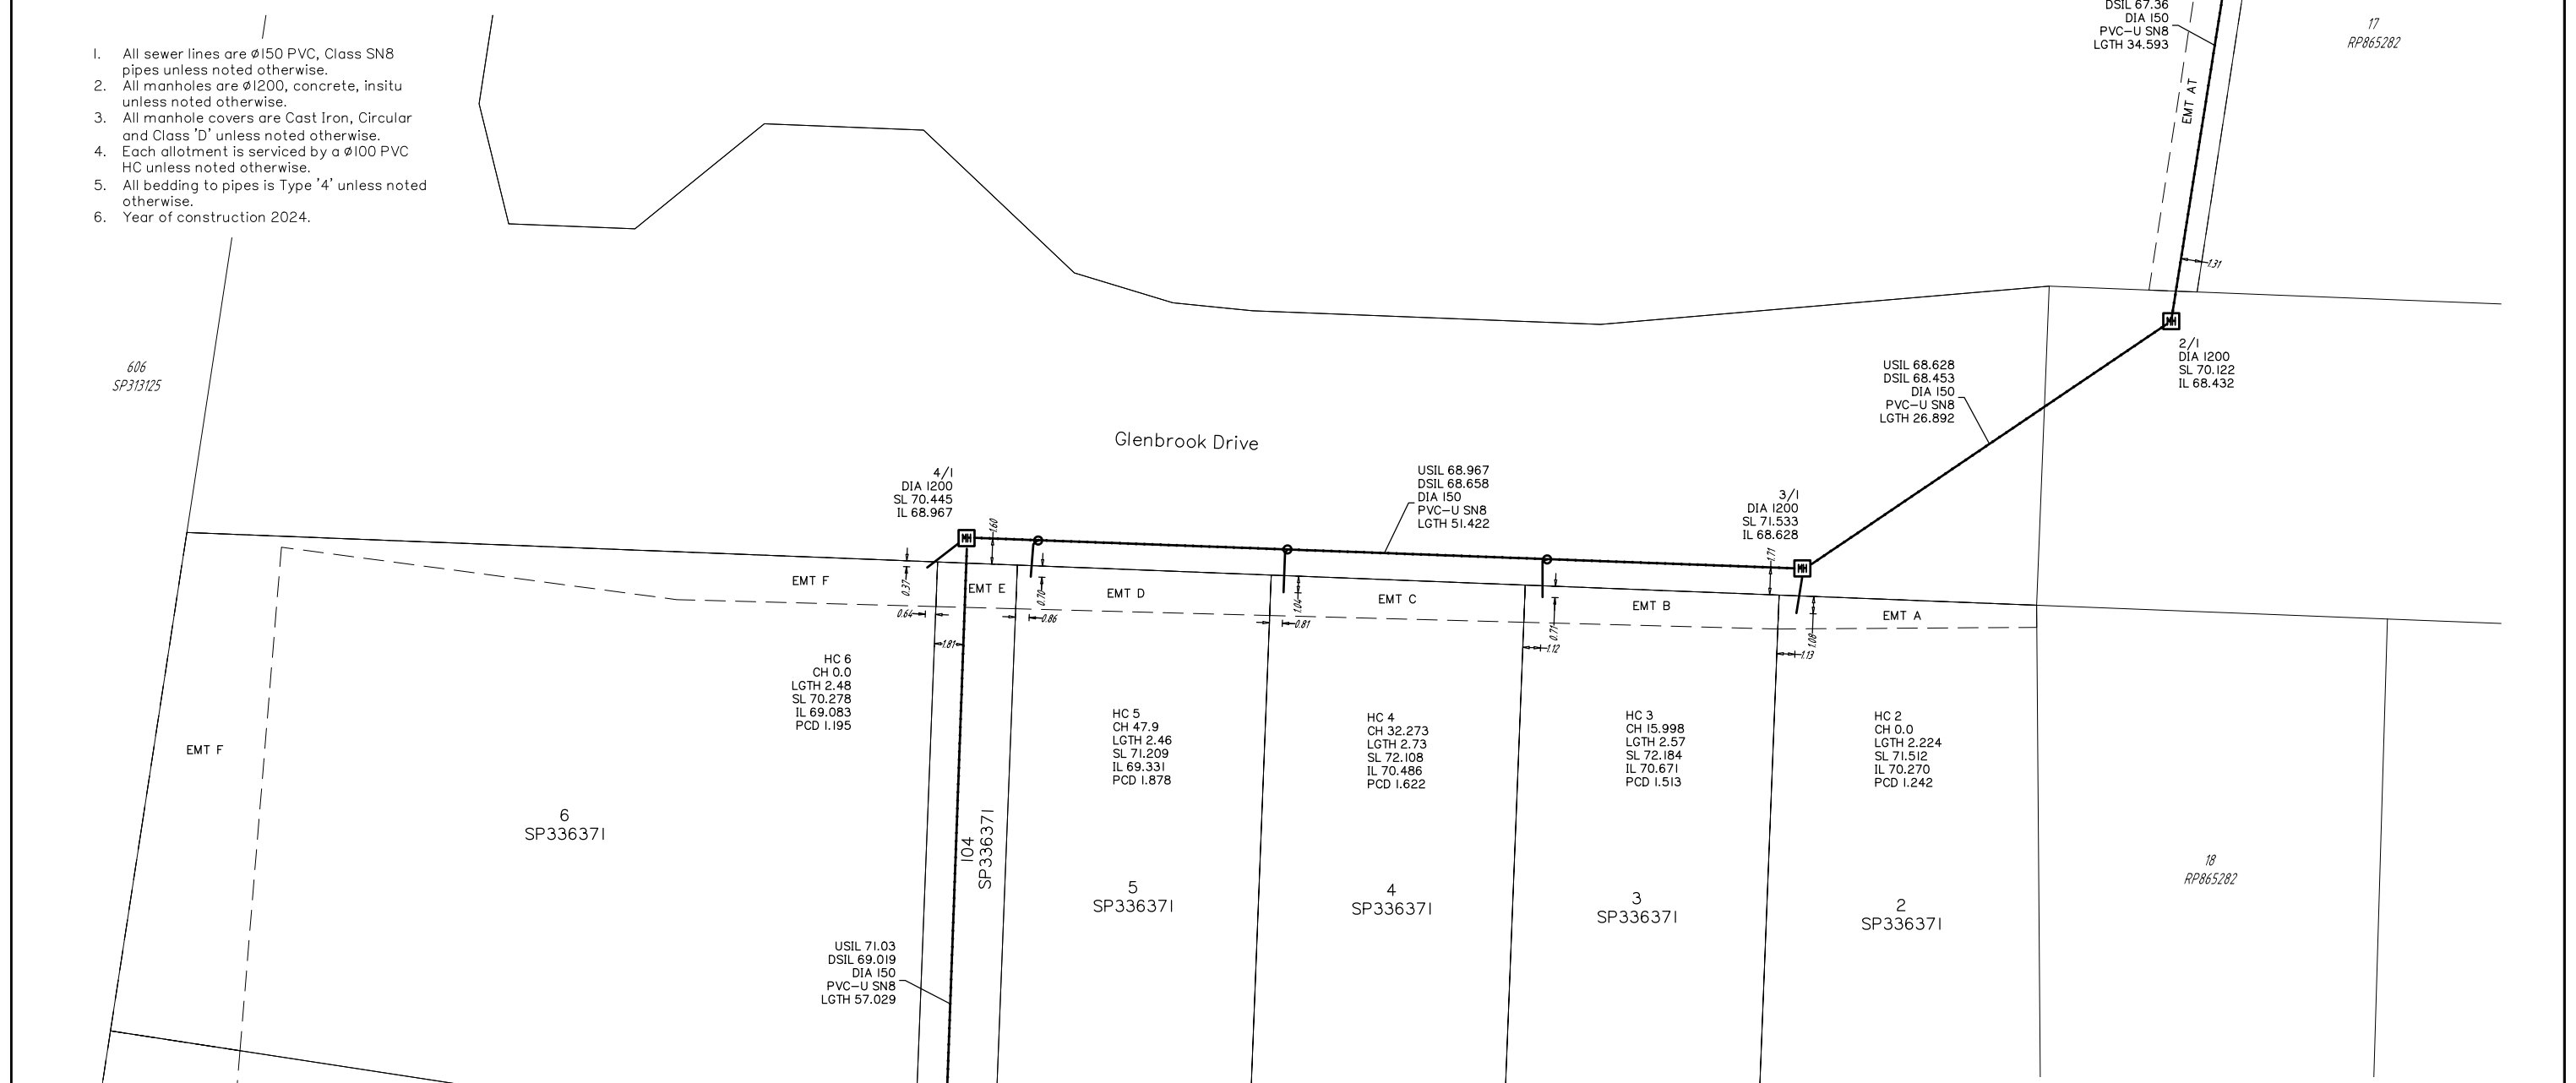

COORDINATE DATUM NOTE:
HORIZONTAL COORDINATES(E,N) SUPPLIED ARE MAPPING GRID OF AUSTRALIA(MGA), ZONE 56 BASED ON THE UNIVERSAL TRANSVERSE MERCATOR PROJECTION AND THE GEOCENTRIC DATUM OF AUSTRALIA 2020.


CONTINUES ON U-2022-4398-3

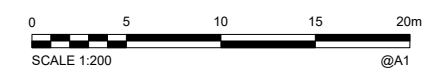

AS CONSTRUCTED


A1	INDEX	DATE	REVISIONS	DRAWN	CHECKED	PASSED	INITIALS	DATE	 urban planning, surveying & development Brisbane PO Box 3126, West End QLD 4101 Ph: 07 3111 0000 Mackay PO Box 11711, Mackay Queensland QLD 4740 Ph: 08 202 278 788 melbourne@dtsold.com.au melbourne@dtsold.com.au	 	Unitywater 201801246750 STAGES 1-4 41 GLENBROOK DRIVE, NAMBOUR AS CONSTRUCTED SEWER	SHEET 2 OF 14 SHEETS	SCALE 1:200
	A	19-02-2024	FINAL AS CONSTRUCTED	AA	SW							REVISION DATE 19-02-2024 REVISION A DISCIPLINE CODE C DRAWING NO. U-2022-4398-2	

CONTINUES ON U-2022-4398-2

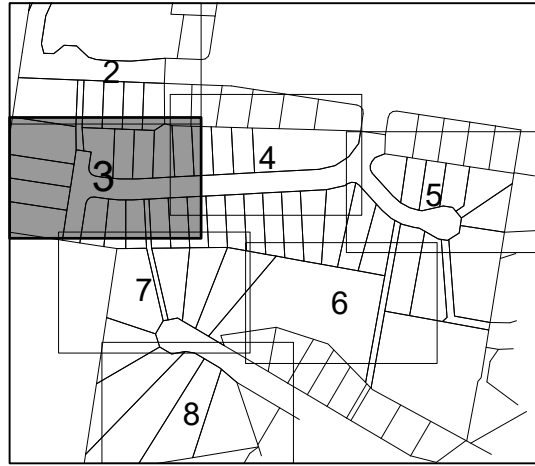

KEY MAP
Scale 1:3000

- All sewer lines are Ø150 PVC, Class SN8 pipes unless noted otherwise.
- All manholes are Ø1200, concrete, insitu unless noted otherwise.
- All manhole covers are Cast Iron, Circular and Class 'D' unless noted otherwise.
- Each allotment is serviced by a Ø100 PVC HC unless noted otherwise.
- All bedding to pipes is Type '4' unless noted otherwise.
- Year of construction 2024.

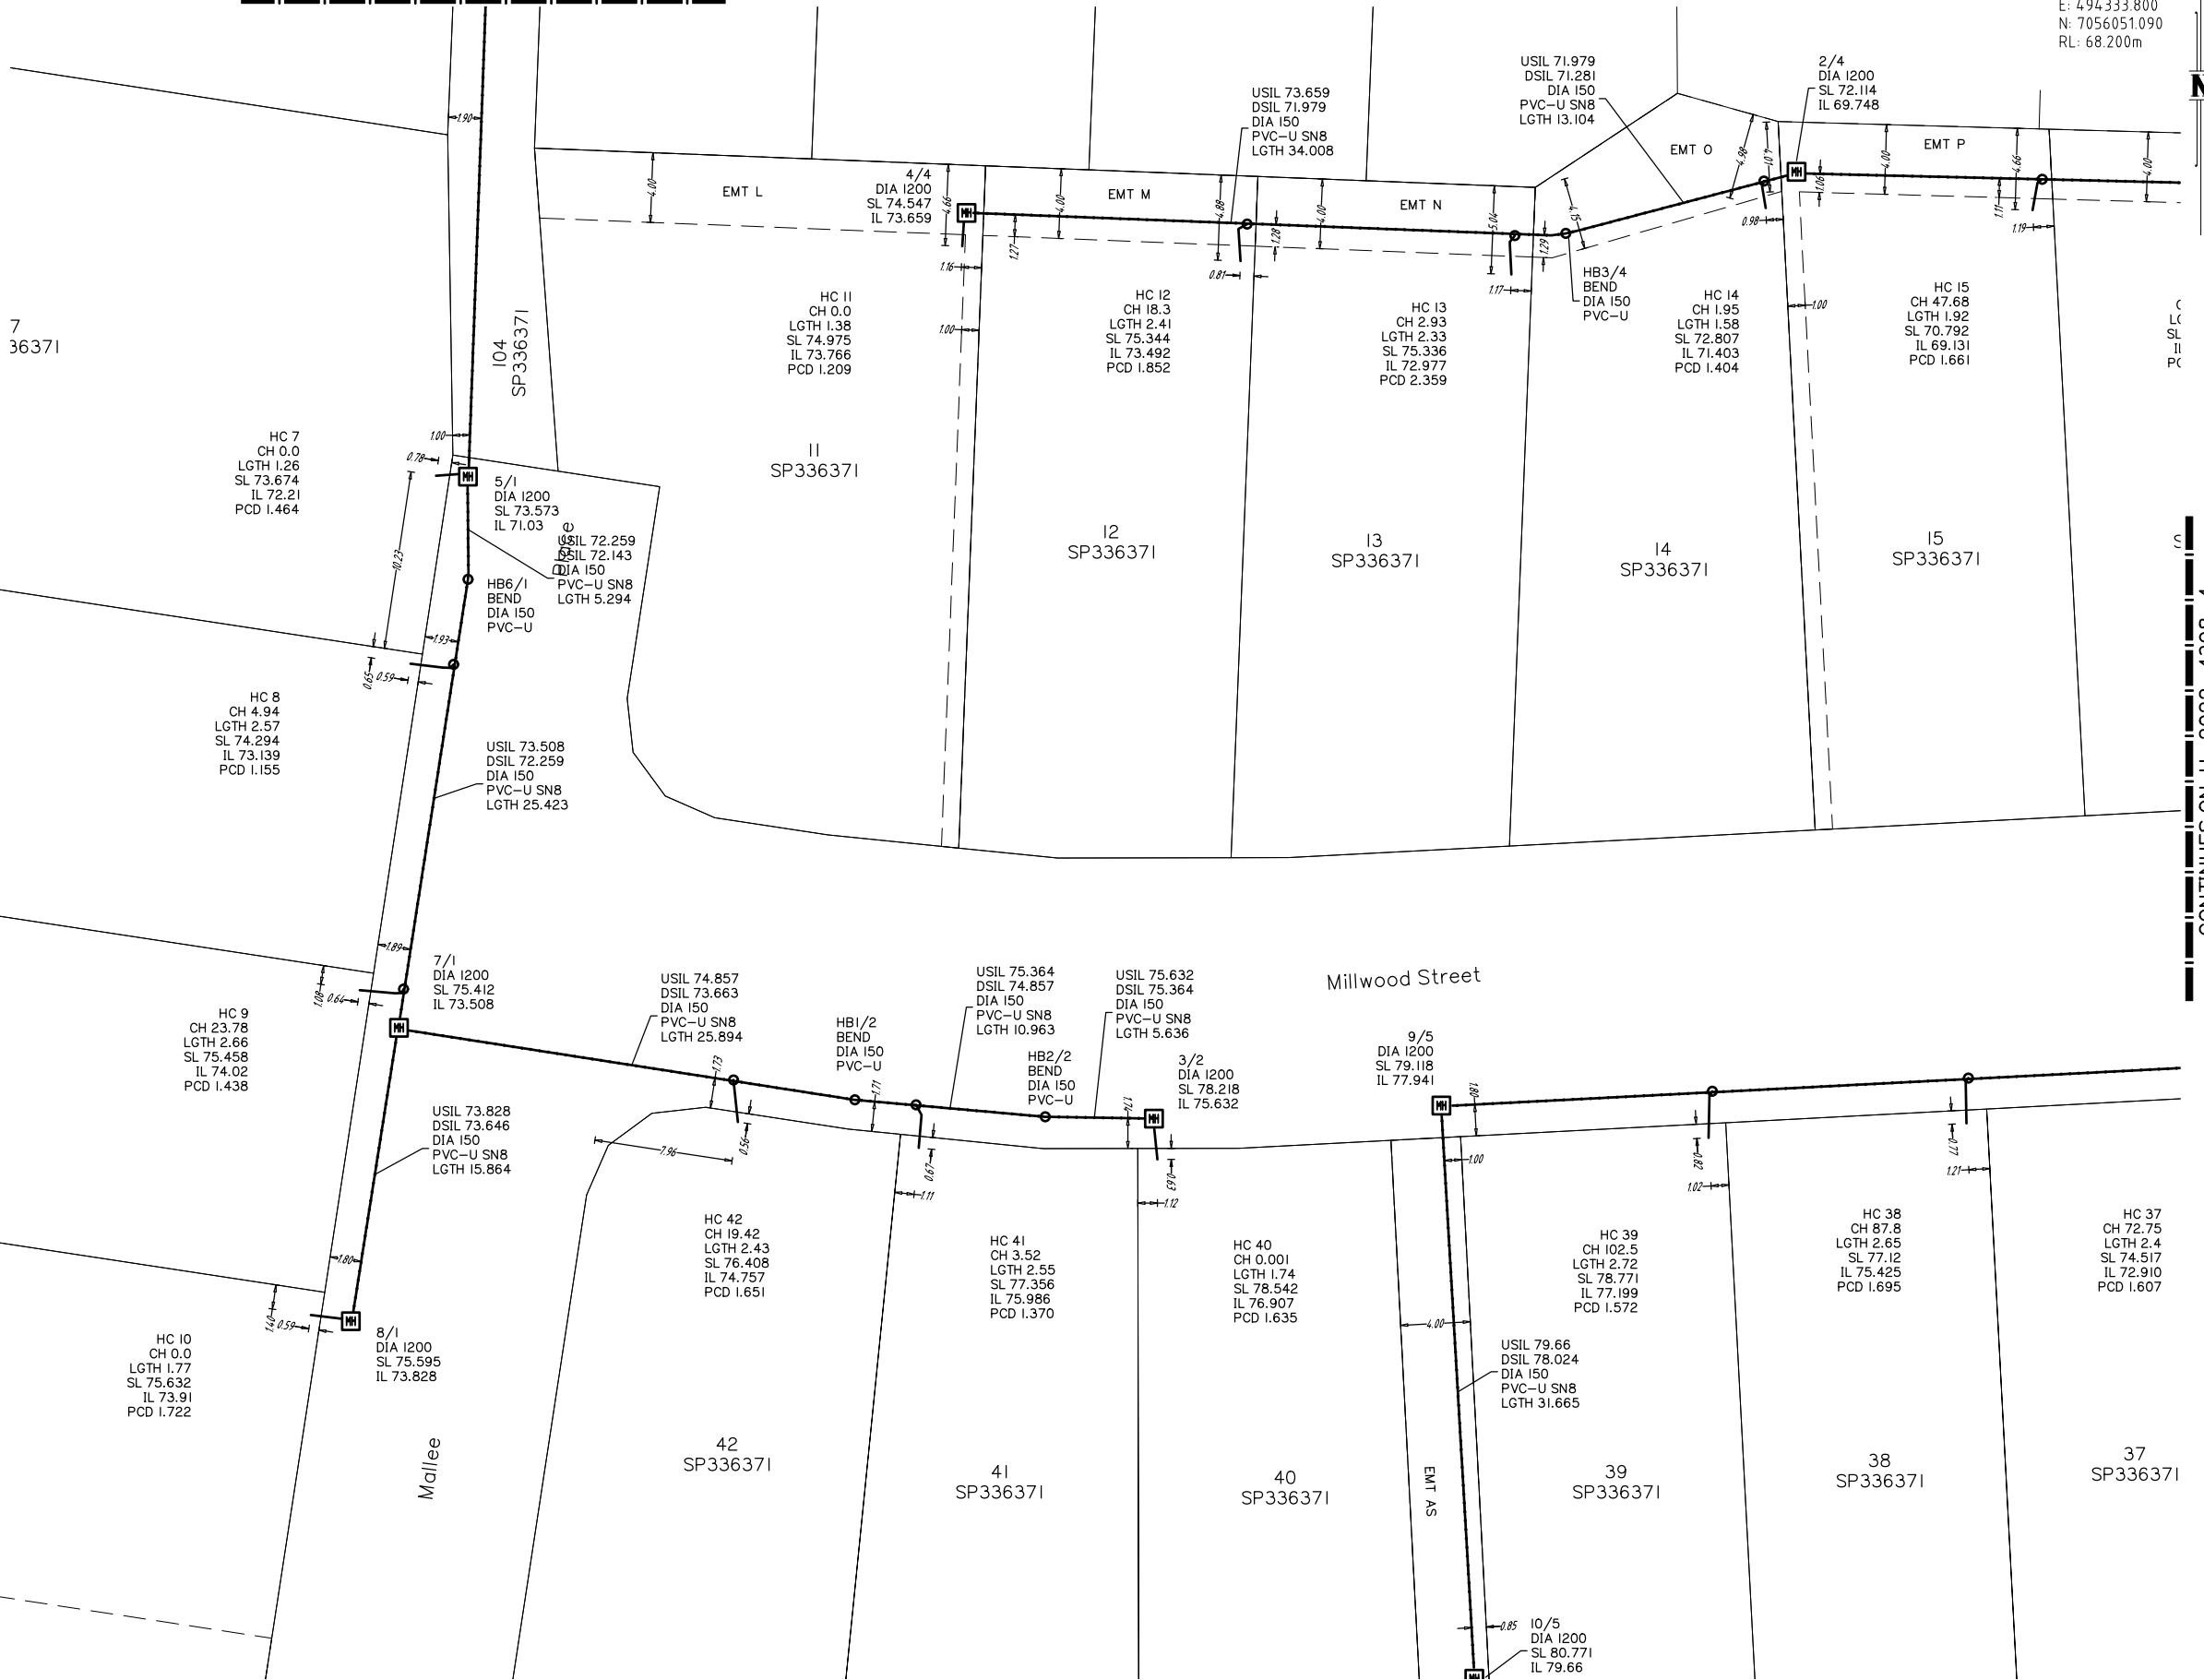

CONTINUES ON U-2022-4398-4

ENGINEER'S CERTIFICATION

- I, _____, hereby certify that:
- The information contained in this drawing / document is in compliance with approved drawings and design.
- The new water and sewerage works defined by this drawing have been designed and constructed in accordance with the SEQ Code.
- This represents an accurate record of as-constructed works
- I accept responsibility for the information contained in this drawing / document.

RPEQ (signature) RPEQ No. _____ Date: _____

REGISTERED SURVEYOR'S CERTIFICATION


I, DTS Group Old Pty Ltd, hereby certify that the vertical and horizontal locations and dimensions shown on this plan are a true and correct record and were located by _____

Registered Surveyor (sig.) Reg. Surveyor No. 3115 Date: 19-02-2024

COORDINATE DATUM NOTE:

HORIZONTAL COORDINATES(E,N) SUPPLIED ARE MAPPING GRID OF AUSTRALIA(MGA), ZONE 56 BASED ON THE UNIVERSAL TRANSVERSE MERCATOR PROJECTION AND THE GEOCENTRIC DATUM OF AUSTRALIA 2020.

CONTINUES ON U-2022-4398-7

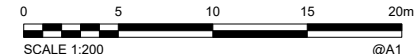

AS CONSTRUCTED

A1

INDEX	DATE	REVISIONS	DRAWN	CHECKED	PASSED
A	19-02-2024	FINAL AS CONSTRUCTED	AA	SW	

DRAWN	AA	19-02-2024
CHECKED	SW	19-02-2024
PASSED		
INITIALS		DATE



Unitywater

201801246750
STAGES 1-4
41 GLENBROOK DRIVE, NAMBOUR
AS CONSTRUCTED SEWER



SHEET 3 OF 14 SHEETS	SCALE 1:200
REVISION DATE 19-02-2024	REVISION A
DISCIPLINE CODE C	
DRAWING NO. U-2022-4398-3	

PSM105139
E: 494.333.800
N: 7056051.090
RL: 68.200m



ENGINEER'S CERTIFICATION
I, _____, hereby certify that:
1. The information contained in this drawing / document is in compliance with approved drawings and design.
2. The new water and sewerage works defined by this drawing have been designed and constructed in accordance with the SEQ Code.
3. This represents an accurate record of as-constructed works.
4. I accept responsibility for the information contained in this drawing / document.
RPEQ (signature) RPEQ No. _____ Date: _____

REGISTERED SURVEYOR'S CERTIFICATION
I, _____, hereby certify that the vertical and horizontal locations and dimensions shown on this plan are a true and correct record and were located by _____.
[Signature]
Registered Surveyor (sig.) Reg. Surveyor No. 3115 Date: 19-02-2024

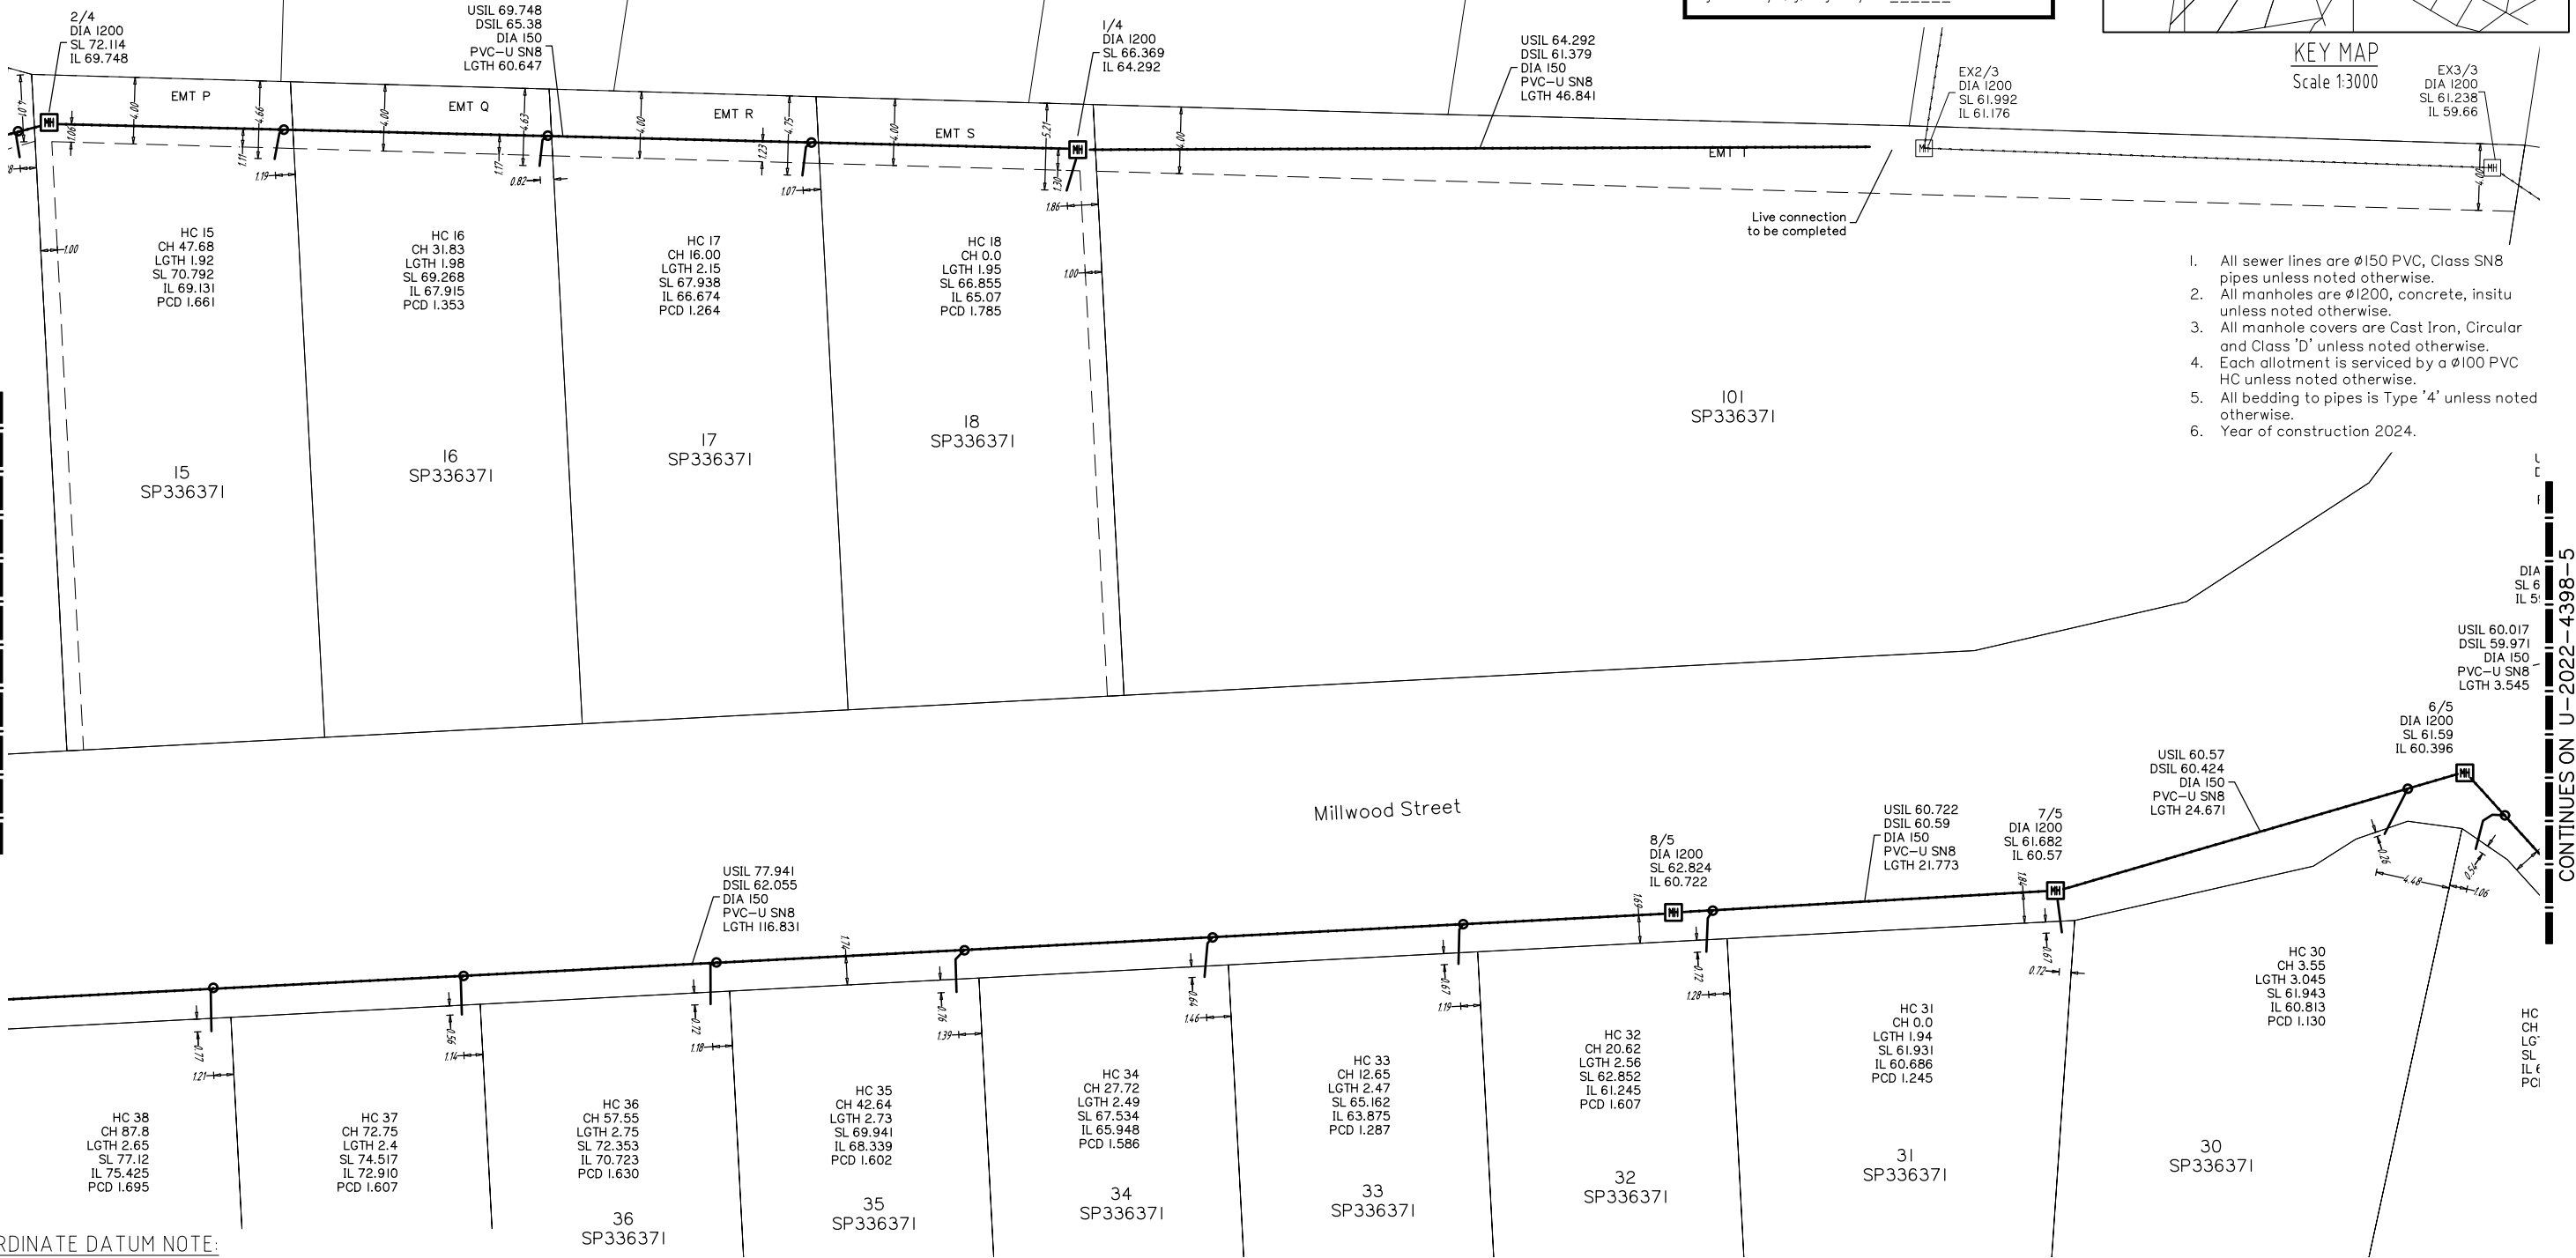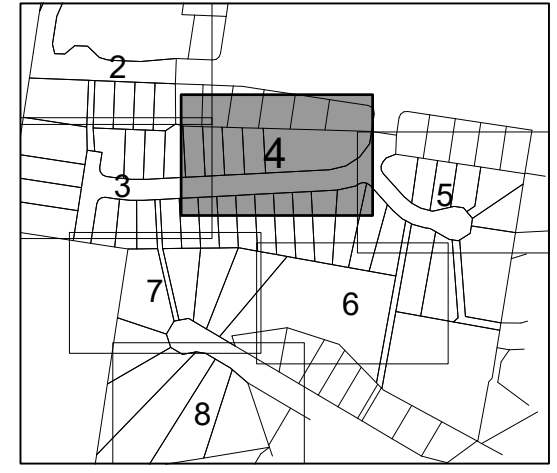


- All sewer lines are \varnothing 150 PVC, Class SN8 pipes unless noted otherwise.
- All manholes are \varnothing 1200, concrete, insitu unless noted otherwise.
- All manhole covers are Cast Iron, Circular and Class 'D' unless noted otherwise.
- Each allotment is serviced by a \varnothing 100 PVC HC unless noted otherwise.
- All bedding to pipes is Type '4' unless noted otherwise.
- Year of construction 2024.

CONTINUES ON U-2022-4398-4

CONTINUES ON U-2022-4398-5

COORDINATE DATUM NOTE:
HORIZONTAL COORDINATES(E,N) SUPPLIED ARE MAPPING GRID OF AUSTRALIA(MGA), ZONE 56 BASED ON THE UNIVERSAL TRANSVERSE MERCATOR PROJECTION AND THE GEOCENTRIC DATUM OF AUSTRALIA 2020.

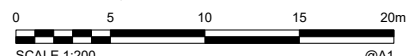

AS CONSTRUCTED

A1	INDEX	DATE	REVISIONS	DRAWN	CHECKED	PASSED
	A	19-02-2024	FINAL AS CONSTRUCTED	AA	SW	

DRAWN	AA	19-02-2024
CHECKED	SW	19-02-2024
PASSED		
INITIALS		DATE

dts urban planning, surveying & development
Brisbane Machay
PO Box 3126, West End QLD 4101 PO Box 11711, Mackay Queensland QLD 4740
Ph: 07 3118 0000 Fax: 1300 278 798
mailto:info@dtsd.com.au



Unitywater
201801246750
STAGES 1-4
41 GLENBROOK DRIVE, NAMBOUR
AS CONSTRUCTED SEWER


SHEET 4 OF 14 SHEETS	SCALE 1:200
REVISION DATE 19-02-2024	REVISION A
DISCIPLINE CODE C	
DRAWING NO. U-2022-4398-4	

PSM105139
 E: 494.333.800
 N: 7056051.090
 RL: 68.200m

CONTINUES ON U-2022-4398-4

COORDINATE DATUM NOTE:
 HORIZONTAL COORDINATES(E,N) SUPPLIED ARE MAPPING GRID OF AUSTRALIA(MGA), ZONE 56 BASED ON THE UNIVERSAL TRANSVERSE MERCATOR PROJECTION AND THE GEOCENTRIC DATUM OF AUSTRALIA 2020.

CONTINUES ON U-2022-4398-6

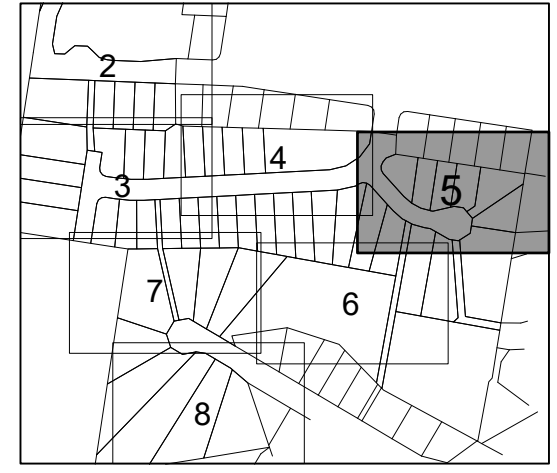

KEY MAP
 Scale 1:3000

1. All sewer lines are Ø150 PVC, Class SN8 pipes unless noted otherwise.
2. All manholes are Ø1200, concrete, insitu unless noted otherwise.
3. All manhole covers are Cast Iron, Circular and Class 'D' unless noted otherwise.
4. Each allotment is serviced by a Ø100 PVC HC unless noted otherwise.
5. All bedding to pipes is Type '4' unless noted otherwise.
6. Year of construction 2024.



ENGINEER'S CERTIFICATION


I, _____, hereby certify that:
 1. The information contained in this drawing / document is in compliance with approved drawings and design.
 2. The new water and sewerage works defined by this drawing have been designed and constructed in accordance with the SEQ Code.
 3. This represents an accurate record of as-constructed works
 4. I accept responsibility for the information contained in this drawing / document.

 RPEQ (signature) RPEQ No. _____ Date: _____

REGISTERED SURVEYOR'S CERTIFICATION

I, _____, DTS Group Qld Pty Ltd, hereby certify that the vertical and horizontal locations and dimensions shown on this plan are a true and correct record and were located by _____

 Registered Surveyor (sig) Reg. Surveyor No. _____ 3115 Date: 19-02-2024

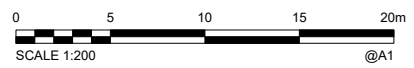

AS CONSTRUCTED

A1

INDEX	DATE	REVISIONS
A	19-02-2024	FINAL AS CONSTRUCTED

DRAWN	CHECKED	PASSED	INITIALS	DATE
AA	SW			19-02-2024
				19-02-2024

dts urban planning, surveying & development
 Brisbane
 PO Box 3126, West End QLD 4101
 Ph: 07 3118 0000
 Brisbane@dtsgroup.com.au


Machay
 PO Box 11711, Mackay Queensland QLD 4740
 Ph: 08 4502 2788
 machay@dtsgroup.com.au



Unitywater

201801246750
 STAGES 1-4
 41 GLENBROOK DRIVE, NAMBOUR
 AS CONSTRUCTED SEWER

SHEET	OF	SHEETS	SCALE
5	14		1:200
REVISION DATE	REVISION		
19-02-2024	A		
DISCIPLINE CODE	DRAWING NO.		
C	U-2022-4398-5		

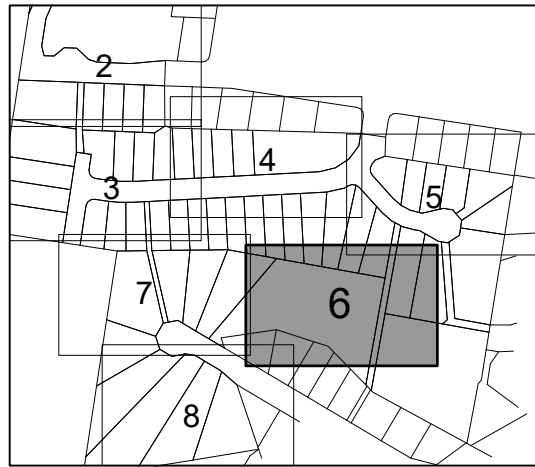

KEY MAP
Scale 1:3000

1. All sewer lines are Ø150 PVC, Class SN8 pipes unless noted otherwise.
2. All manholes are Ø1200, concrete, insitu unless noted otherwise.
3. All manhole covers are Cast Iron, Circular and Class 'D' unless noted otherwise.
4. Each allotment is serviced by a Ø100 PVC HC unless noted otherwise.
5. All bedding to pipes is Type '4' unless noted otherwise.
6. Year of construction 2024.

PSM105139
E: 494333.800
N: 7056051.090
RL: 68.200m



CONTINUES ON U-2022-4398-5

UH 4.35
LGTH 2.54
SL 67.925
IL 66.530
PCD 1.395
26
SP336371

USIL 71.043
DSIL 63.643
DIA 150
PVC-U SN8
LGTH 48.869

27
SP336371

EMT AD

EMT AR

1/8
DIA 1200
SL 72.248
IL 71.043

HC 50
CH 2.21
LGTH 4.31
SL 73.130
IL 72.290
PCD 0.840

USIL 77.691
DSIL 71.086
DIA 150
PVC-U SN8
LGTH 26.211

50
SP336371

2/8
DIA 1200
SL 78.968
IL 77.691

EMT AC

HC 49
CH 0.0
LGTH 1.56
SL 79.477
IL 78.157
PCD 1.320

103
SP336371

49
SP336371

8
RP95218

9
RP95218


10
RP95218

11
RP95218

ENGINEER'S CERTIFICATION
I, _____, hereby certify that:
1. The information contained in this drawing / document is in compliance with approved drawings and design.
2. The new water and sewerage works defined by this drawing have been designed and constructed in accordance with the SEQ Code.
3. This represents an accurate record of as-constructed works.
4. I accept responsibility for the information contained in this drawing / document.
RPEQ (signature) RPEQ No. _____ Date: _____


REGISTERED SURVEYOR'S CERTIFICATION
I, DTS Group Qld Pty Ltd, hereby certify that the vertical and horizontal locations and dimensions shown on this plan are a true and correct record and were located by survey.
[Signature]
Registered Surveyor (sig) Reg. Surveyor No. 3115 Date: 19-02-2024

COORDINATE DATUM NOTE:
HORIZONTAL COORDINATES(E,N) SUPPLIED ARE MAPPING GRID OF AUSTRALIA(MGA), ZONE 56 BASED ON THE UNIVERSAL TRANSVERSE MERCATOR PROJECTION AND THE GEOCENTRIC DATUM OF AUSTRALIA 2020.

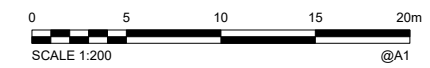

AS CONSTRUCTED

A1	INDEX	DATE	REVISIONS	DRAWN	CHECKED	PASSED	INITIALS	DATE	urban planning, surveying & development Brisbane PO Box 3126, West End QLD 4101 Ph: 07 3118 9900 Machay PO Box 11711, Mackay Queensland QLD 4740 Ph: 1300 276 786 	Unitywater 201801246750 STAGES 1-4 41 GLENBROOK DRIVE, NAMBOUR AS CONSTRUCTED SEWER	SHEET 6 OF 14 SHEETS	SCALE 1:200
	A	19-02-2024	FINAL AS CONSTRUCTED	AA	SW						REVISION DATE 19-02-2024 REVISION A DISCIPLINE CODE C DRAWING NO. U-2022-4398-6	

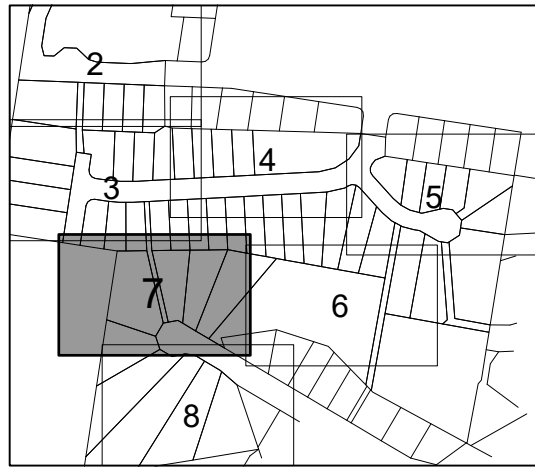

KEY MAP
Scale 1:3000

- All sewer lines are $\phi 150$ PVC, Class SN8 pipes unless noted otherwise.
- All manholes are $\phi 1200$, concrete, insitu unless noted otherwise.
- All manhole covers are Cast Iron, Circular and Class 'D' unless noted otherwise.
- Each allotment is serviced by a $\phi 100$ PVC HC unless noted otherwise.
- All bedding to pipes is Type '4' unless noted otherwise.
- Year of construction 2024.

188606

ENGINEER'S CERTIFICATION

- I, _____ hereby certify that:
- The information contained in this drawing / document is in compliance with approved drawings and design.
 - The new water and sewerage works defined by this drawing have been designed and constructed in accordance with the SEQ Code.
 - This represents an accurate record of as-constructed works.
 - I accept responsibility for the information contained in this drawing / document.

RPEQ (signature) RPEQ No. _____ Date: _____


REGISTERED SURVEYOR'S CERTIFICATION

I, DTS Group Qld Pty Ltd, hereby certify that the vertical and horizontal locations and dimensions shown on this plan are a true and correct record and were located by survey.

Registered Surveyor (sig) Reg. Surveyor No. 3115 Date: 19-02-2024


PSM105139
E: 494333.800
N: 7056051.090
RL: 68.200m

CONTINUES ON U-2022-4398-3

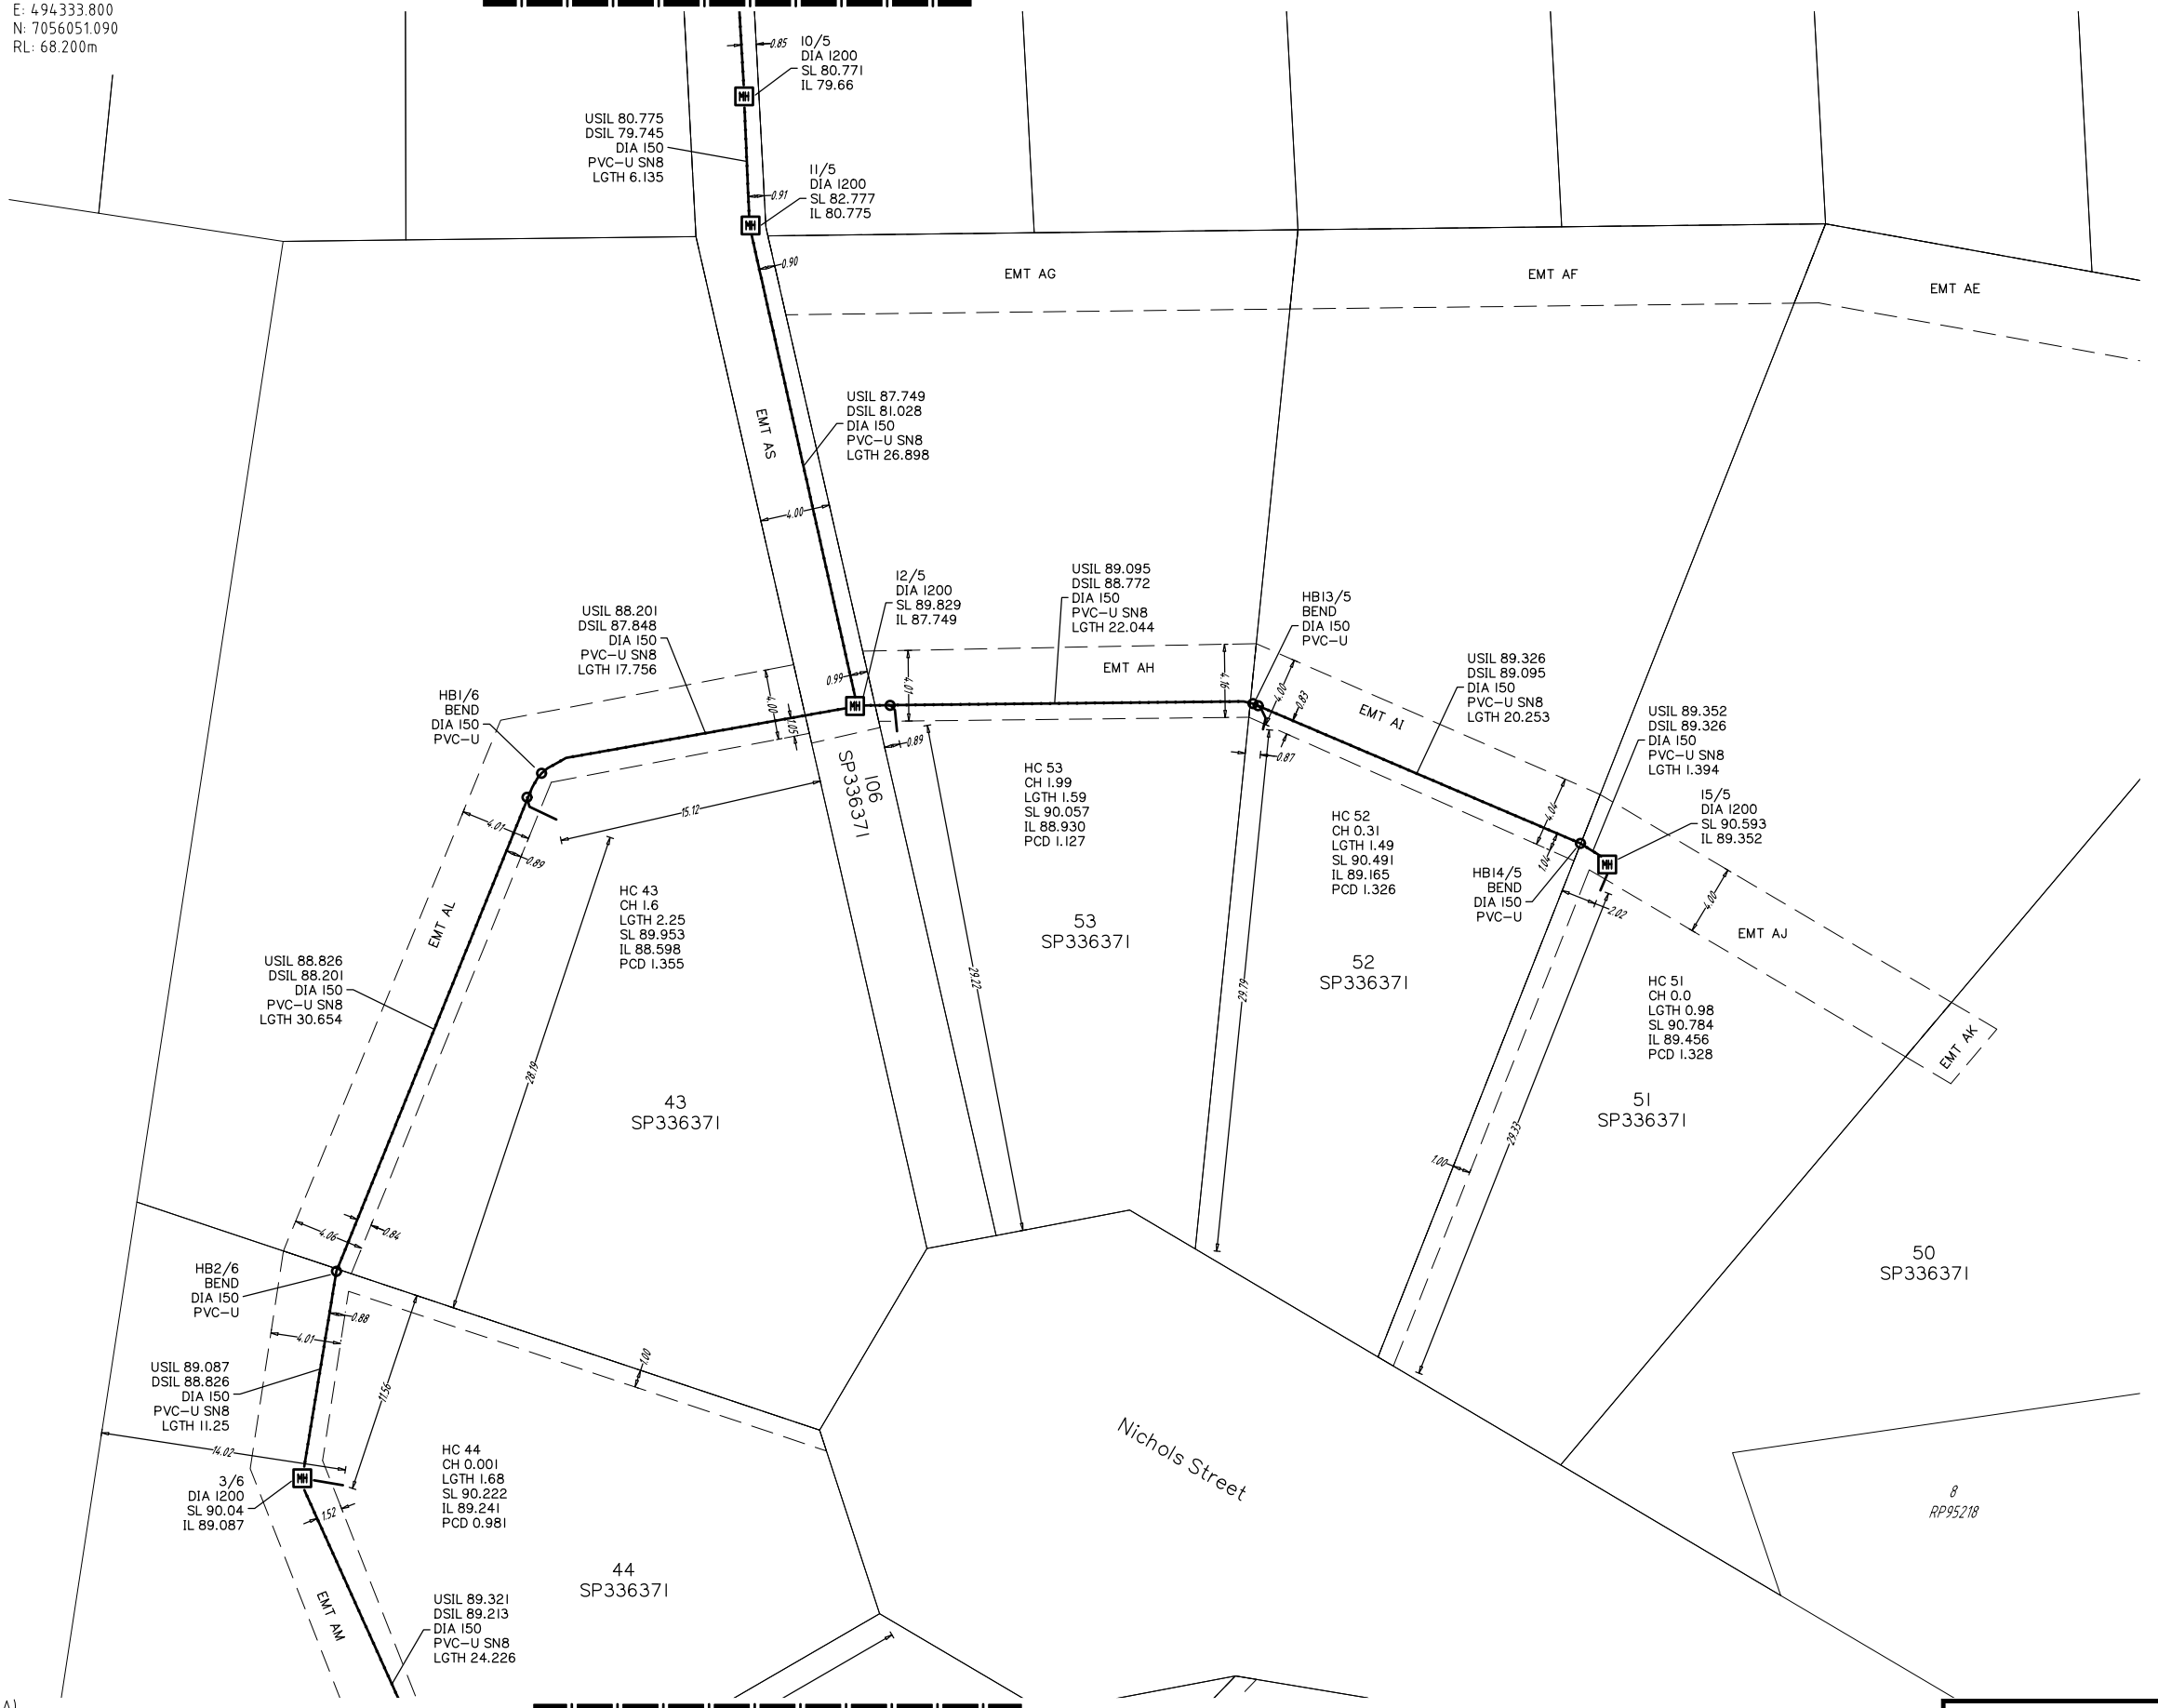

CONTINUES ON U-2022-4398-8

COORDINATE DATUM NOTE:
HORIZONTAL COORDINATES(E,N) SUPPLIED ARE MAPPING GRID OF AUSTRALIA(MGA), ZONE 56 BASED ON THE UNIVERSAL TRANSVERSE MERCATOR PROJECTION AND THE GEOCENTRIC DATUM OF AUSTRALIA 2020.

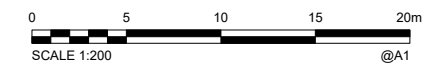


AS CONSTRUCTED

A1	INDEX	DATE	REVISIONS	DRAWN	CHECKED	PASSED	INITIALS	DATE	 urban planning, surveying & development Brisbane PO Box 3126, West End QLD 4101 Ph: 07 3118 0000 machay@dtsd.com.au	 Machay PO Box 11711, Mackay Queensland QLD 4740 Ph: 08 200 278 788 machay@colliers.com.au	 Unitywater	Unitywater 201801246750 STAGES 1-4 41 GLENBROOK DRIVE, NAMBOUR AS CONSTRUCTED SEWER		SHEET 7 OF 14 SHEETS REVISION DATE 19-02-2024 DISCIPLINE CODE C DRAWING NO. U-2022-4398-7	SCALE 1:200 REVISION A
	A	19-02-2024	FINAL AS CONSTRUCTED	AA	SW										

PSM105139
 E: 494333.800
 N: 7056051.090
 RL: 68.200m

CONTINUES ON U-2022-4398-7

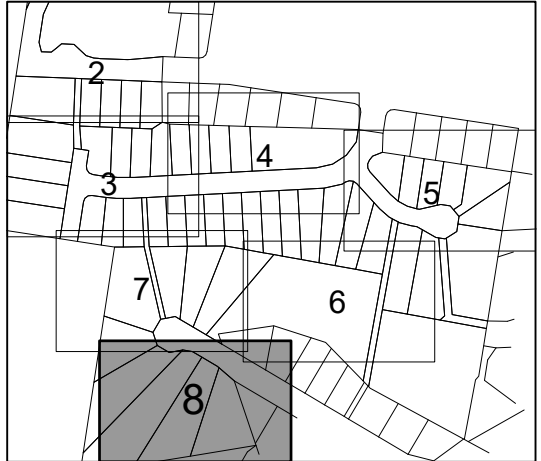

1. All sewer lines are ϕ 150 PVC, Class SN8 pipes unless noted otherwise.
2. All manholes are ϕ 1200, concrete, insitu unless noted otherwise.
3. All manhole covers are Cast Iron, Circular and Class 'D' unless noted otherwise.
4. Each allotment is serviced by a ϕ 100 PVC HC unless noted otherwise.
5. All bedding to pipes is Type '4' unless noted otherwise.
6. Year of construction 2024.

ENGINEER'S CERTIFICATION

I, _____, hereby certify that:
 1. The information contained in this drawing / document is in compliance with approved drawings and design.
 2. The new water and sewerage works defined by this drawing have been designed and constructed in accordance with the SEQ Code.
 3. This represents an accurate record of as-constructed works.
 4. I accept responsibility for the information contained in this drawing / document.


RPEO (signature) RPEO No. _____ Date: _____

REGISTERED SURVEYOR'S CERTIFICATION

I, DTS Group Old Pty Ltd, hereby certify that the vertical and horizontal locations and dimensions shown on this plan are a true and correct record and were located by survey.

[Signature]
 Registered Surveyor (sig) Reg. Surveyor No. 3115 Date: 19-02-2024

COORDINATE DATUM NOTE:
 HORIZONTAL COORDINATES(E,N) SUPPLIED ARE MAPPING GRID OF AUSTRALIA(MGA), ZONE 56 BASED ON THE UNIVERSAL TRANSVERSE MERCATOR PROJECTION AND THE GEOCENTRIC DATUM OF AUSTRALIA 2020.

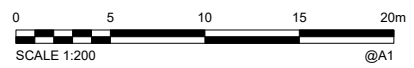

AS CONSTRUCTED


A1	INDEX	DATE	REVISIONS	DRAWN	CHECKED	PASSED	INITIALS	DATE
	A	19-02-2024	FINAL AS CONSTRUCTED	AA	SW			

DRAWN	AA	19-02-2024
CHECKED	SW	19-02-2024
PASSED		



Unitywater
 201801246750
 STAGES 1-4
 41 GLENBROOK DRIVE, NAMBOUR
 AS CONSTRUCTED SEWER

SHEET 8 OF 14 SHEETS	SCALE 1:200
REVISION DATE 19-02-2024	REVISION A
DISCIPLINE CODE C	
DRAWING NO. U-2022-4398-8	

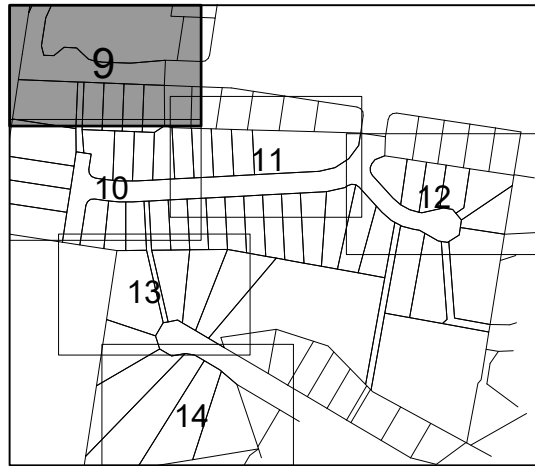


KEY MAP
Scale 1:3000


ENGINEER'S CERTIFICATION
 I, _____, hereby certify that:
 1. The information contained in this drawing / document is in compliance with approved drawings and design.
 2. The new water and sewerage works defined by this drawing have been designed and constructed in accordance with the SEQ Code.
 3. This represents an accurate record of as-constructed works.
 4. I accept responsibility for the information contained in this drawing / document.
 RPEQ (signature) RPEQ No. _____ Date: _____

REGISTERED SURVEYOR'S CERTIFICATION
 DTS Group Old Pty Ltd _____ hereby certify that the vertical and horizontal locations and dimensions shown on this plan are a true and correct record and were located by survey.
 Registered Surveyor (sig) _____ Reg. Surveyor No. 3115 Date: 19-02-2024

SP336371

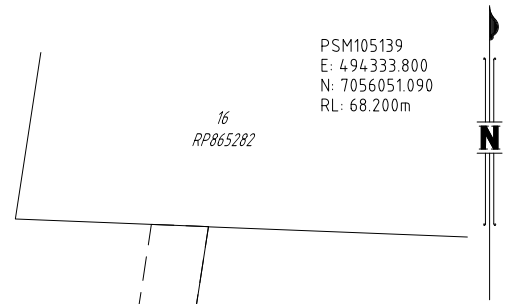


LEGEND
 FH ● FIRE HYDRANT
 V ◻ VALVE
 W ◻ WATER METER

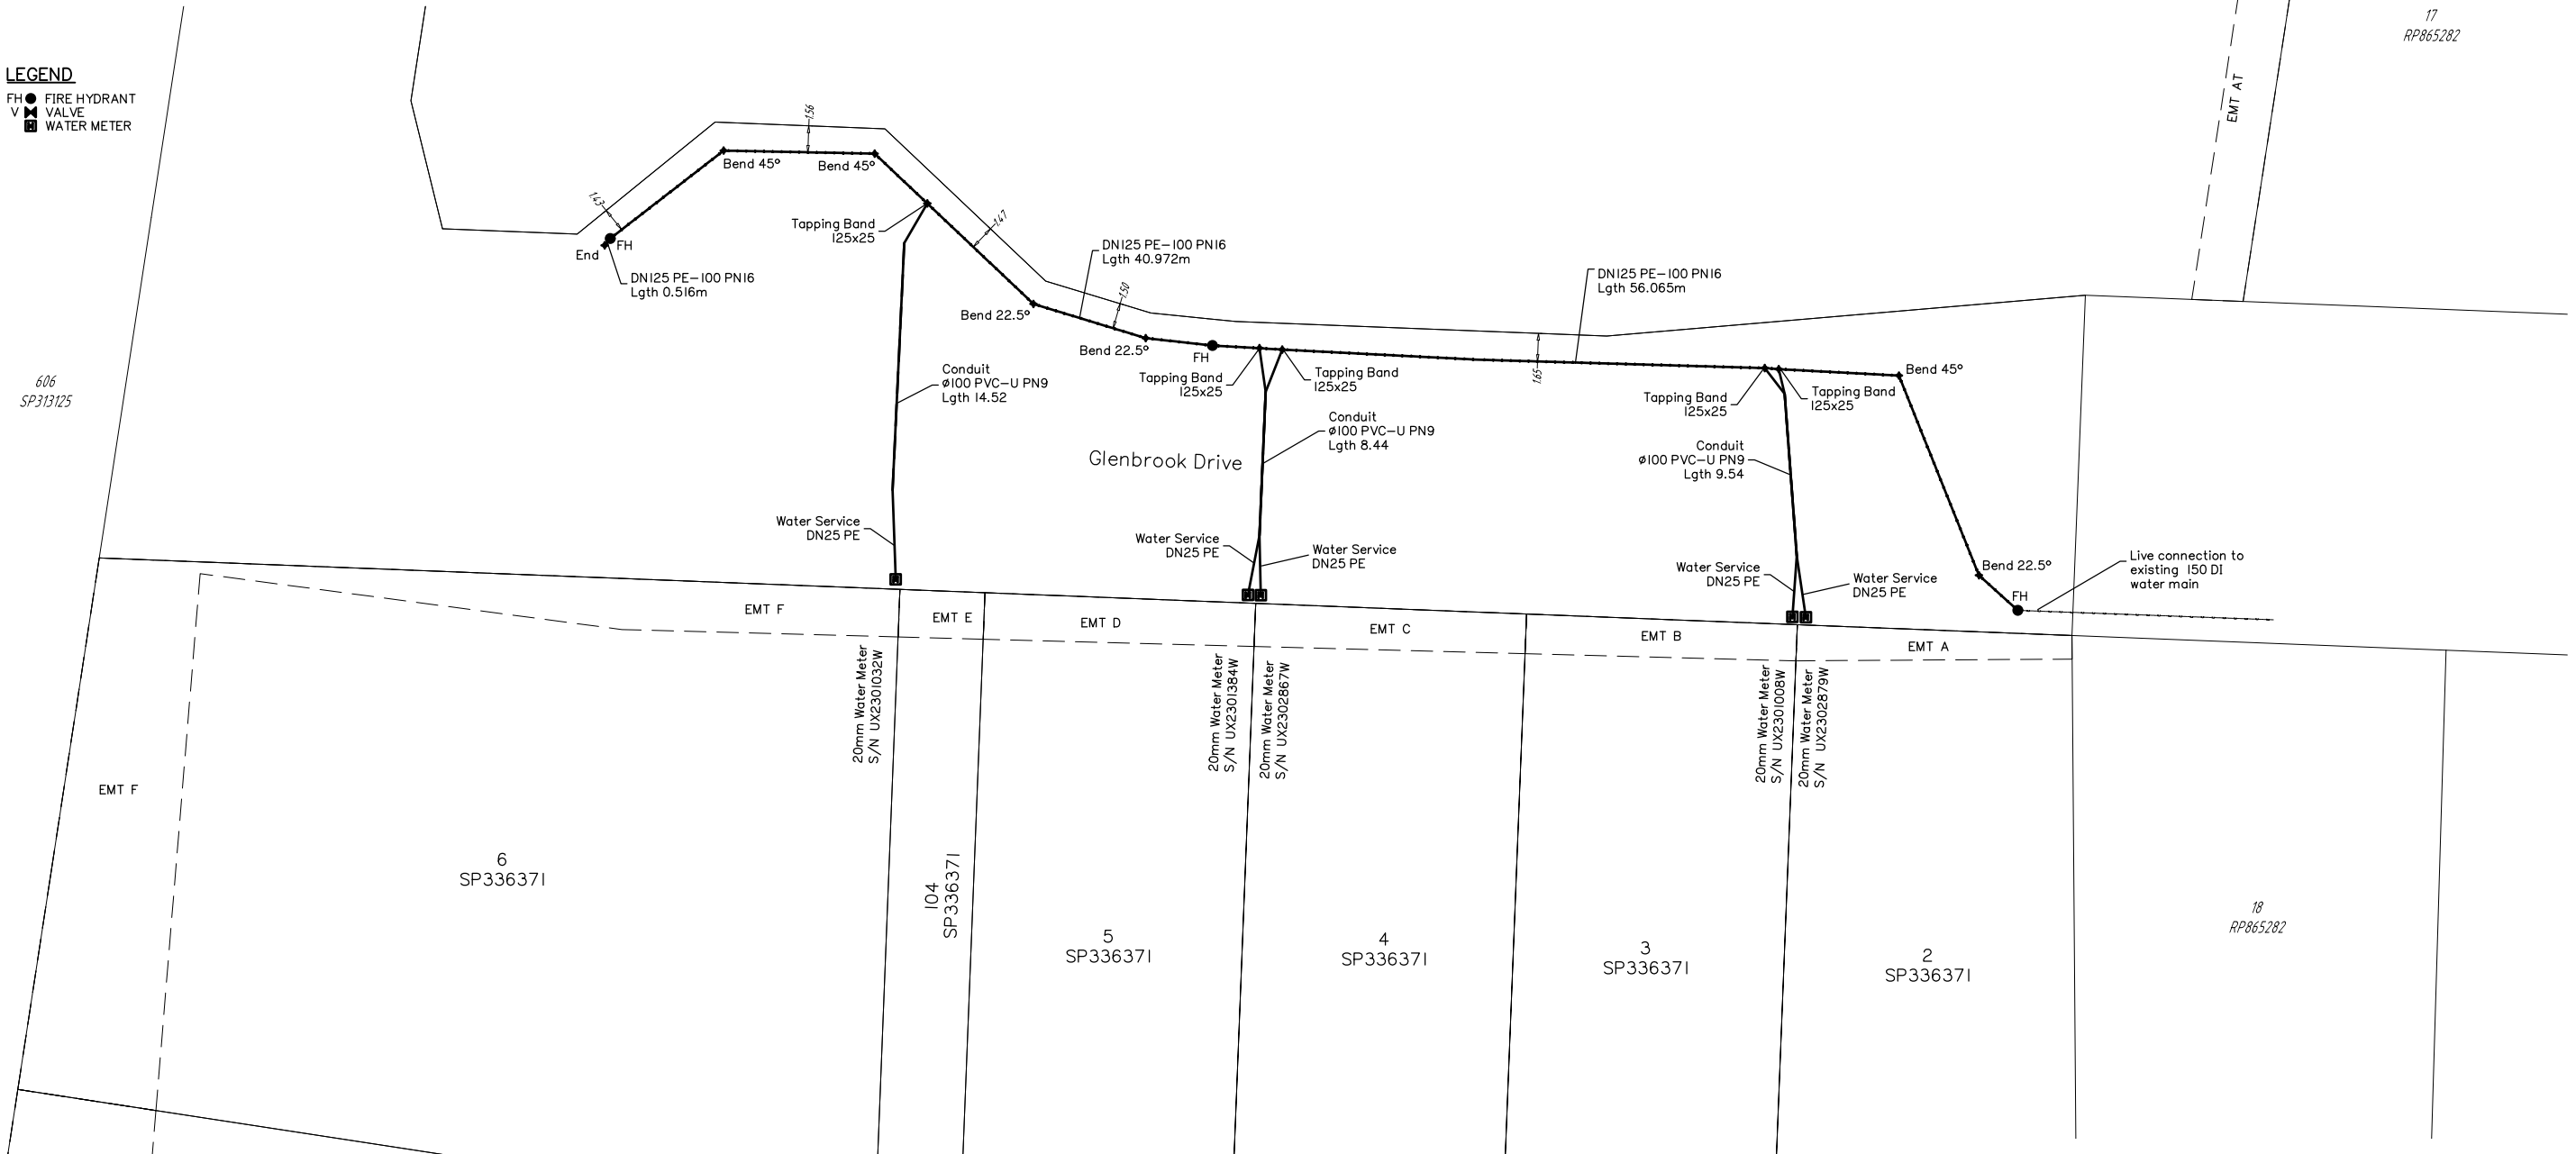

COORDINATE DATUM NOTE:
 HORIZONTAL COORDINATES(E,N) SUPPLIED ARE MAPPING GRID OF AUSTRALIA(MGA), ZONE 56 BASED ON THE UNIVERSAL TRANSVERSE MERCATOR PROJECTION AND THE GEOCENTRIC DATUM OF AUSTRALIA 2020.

CONTINUES ON U-2022-4398-10

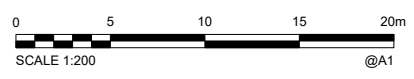


AS CONSTRUCTED

A1	INDEX	DATE	REVISIONS	DRAWN	CHECKED	PASSED	INITIALS	DATE	 Brisbane PO Box 3126, West End QLD 4101 Ph: 07 3118 0000 Machay PO Box 11711, Mackay Queensland QLD 4740 Ph: 08 202 278 788 machay@dtsgroup.com.au	 	Unitywater 201801246750 STAGES 1-4 41 GLENBROOK DRIVE, NAMBOUR AS CONSTRUCTED WATER	SHEET 9 OF 14 SHEETS	SCALE 1:200
	A	19-02-2024	FINAL AS CONSTRUCTED	AA	SW							REVISION DATE 19-02-2024 REVISION A DISCIPLINE CODE C DRAWING NO. U-2022-4398-9	

CONTINUES ON U-2022-4398-9


PSM105139
E: 494333.800
N: 7056051.090
RL: 68.200m

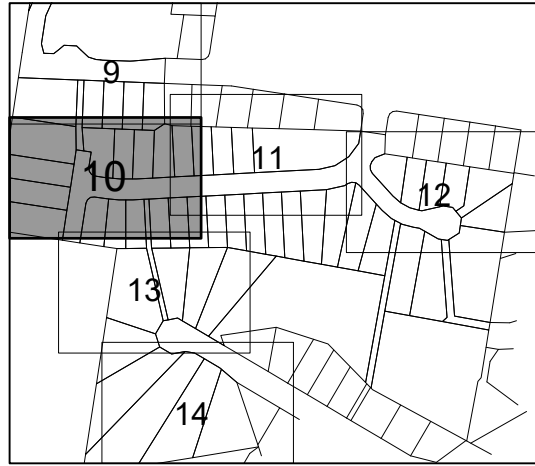

KEY MAP
Scale 1:3000

LEGEND

- FH ● FIRE HYDRANT
- V ▽ VALVE
- WM □ WATER METER

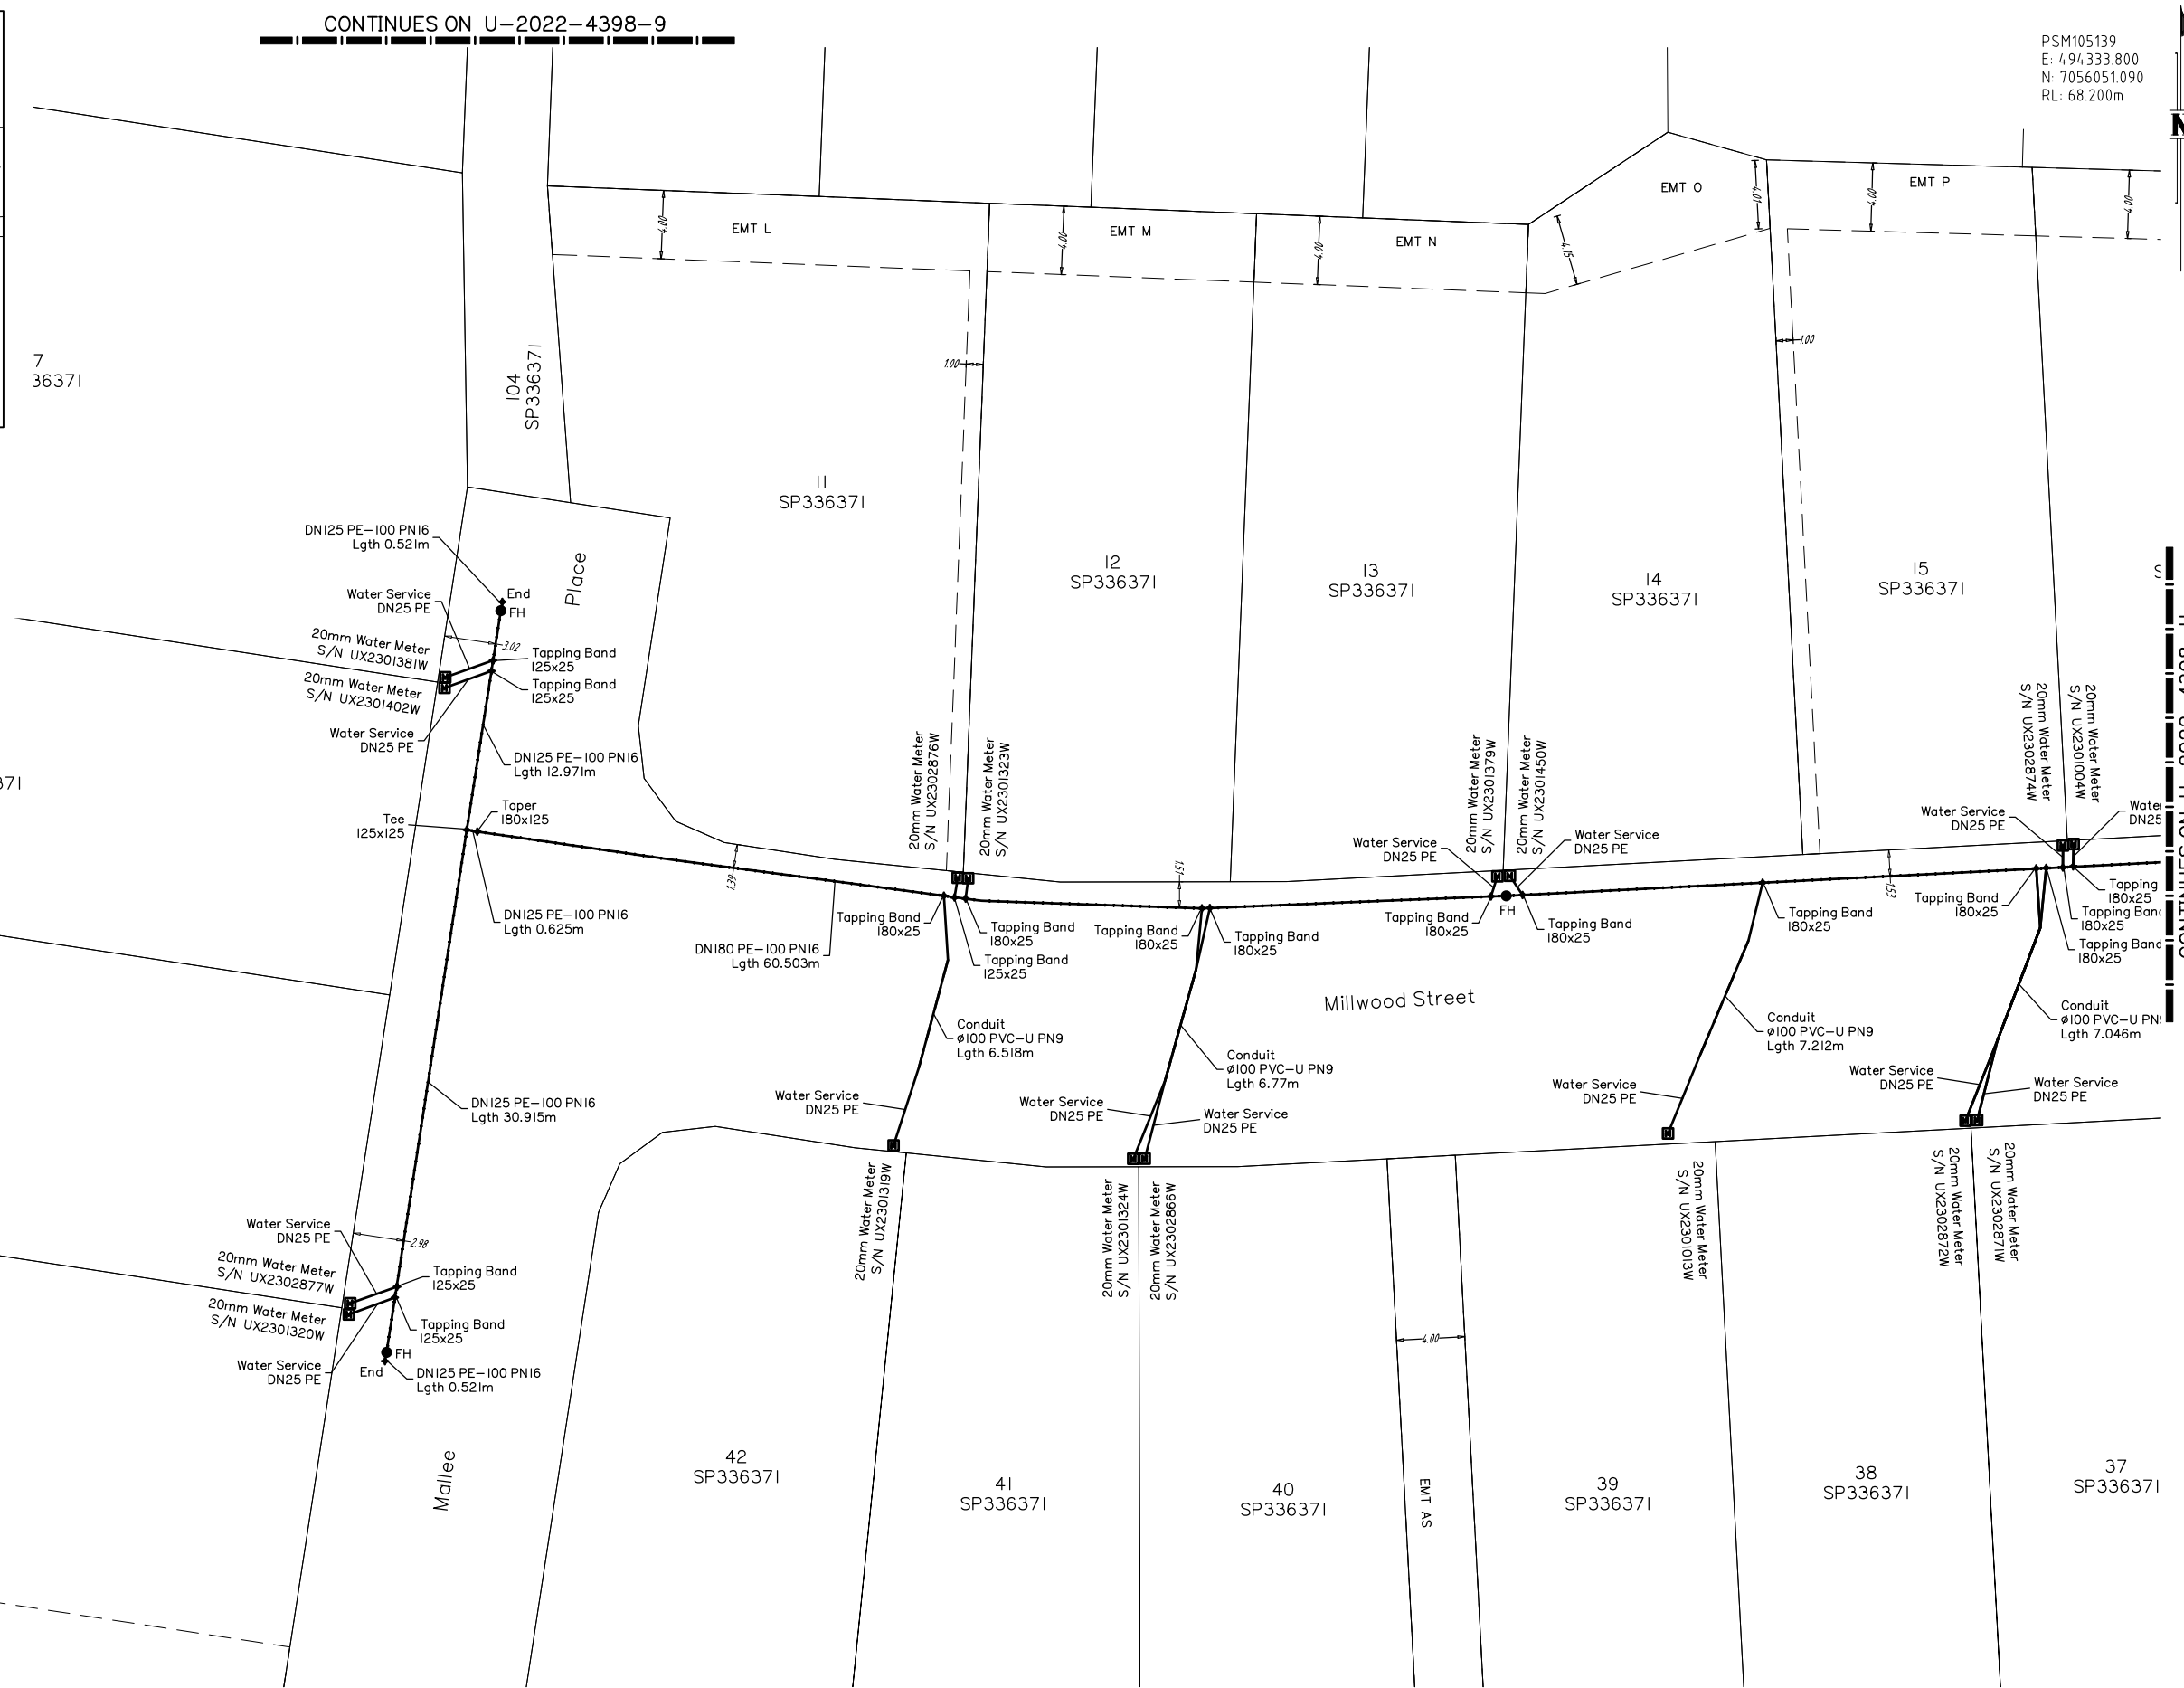

CONTINUES ON U-2022-4398-11

ENGINEER'S CERTIFICATION

I, _____, hereby certify that:

- The information contained in this drawing / document is in compliance with approved drawings and design.
- The new water and sewerage works defined by this drawing have been designed and constructed in accordance with the SEQ Code.
- This represents an accurate record of as-constructed works.
- I accept responsibility for the information contained in this drawing / document.

RPEQ (signature) RPEQ No. _____ Date: _____


REGISTERED SURVEYOR'S CERTIFICATION

I, DTS Group Old Pty Ltd, hereby certify that the vertical and horizontal locations and dimensions shown on this plan are a true and correct record and were located by _____

Registered Surveyor (sig.) Reg. Surveyor No. 3115 Date: 19-02-2024

COORDINATE DATUM NOTE:
HORIZONTAL COORDINATES(E,N) SUPPLIED ARE MAPPING GRID OF AUSTRALIA(MGA), ZONE 56 BASED ON THE UNIVERSAL TRANSVERSE MERCATOR PROJECTION AND THE GEOCENTRIC DATUM OF AUSTRALIA 2020.

CONTINUES ON U-2022-4398-13

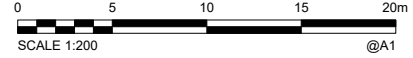

AS CONSTRUCTED

A1	INDEX	DATE	REVISIONS	DRAWN	CHECKED	PASSED	INITIALS	DATE
	A	19-02-2024	FINAL AS CONSTRUCTED	AA	SW			

DRAWN	AA	19-02-2024
CHECKED	SW	19-02-2024
PASSED		



Unitywater

201801246750
STAGES 1-4
41 GLENBROOK DRIVE, NAMBOUR
AS CONSTRUCTED WATER

SHEET 10 OF 14 SHEETS	SCALE 1:200
REVISION DATE 19-02-2024	REVISION A
DISCIPLINE CODE C	
DRAWING NO. U-2022-4398-10	

PSM105139
E: 494333.800
N: 7056051.090
RL: 68.200m



18
RP865282

19
RP865282

20
RP865282

21
RP865282

ENGINEER'S CERTIFICATION


I, _____, hereby certify that:
1. The information contained in this drawing / document is in compliance with approved drawings and design.
2. The new water and sewerage works defined by this drawing have been designed and constructed in accordance with the SEQ Code.
3. This represents an accurate record of as-constructed works.
4. I accept responsibility for the information contained in this drawing / document.

RPEQ (signature) RPEQ No. _____ Date: _____

REGISTERED SURVEYOR'S CERTIFICATION


I, DTS Group Old Pty Ltd, hereby certify that the vertical and horizontal locations and dimensions shown on this plan are a true and correct record and were located by survey.

Registered Surveyor (sig) Reg. Surveyor No. 3115 Date: 19-02-2024

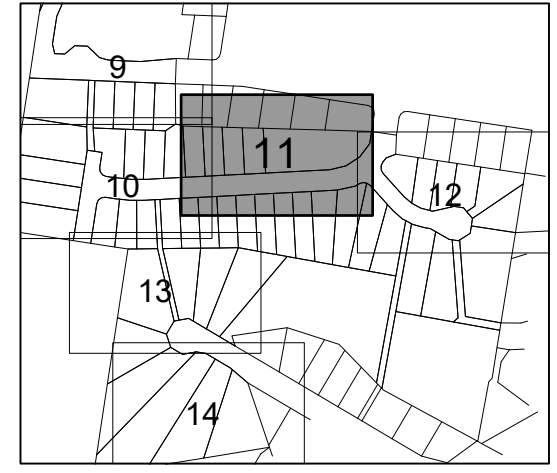

KEY MAP
Scale 1:3000


- LEGEND**
- FH ● FIRE HYDRANT
 - V ◻ VALVE
 - W ◻ WATER METER

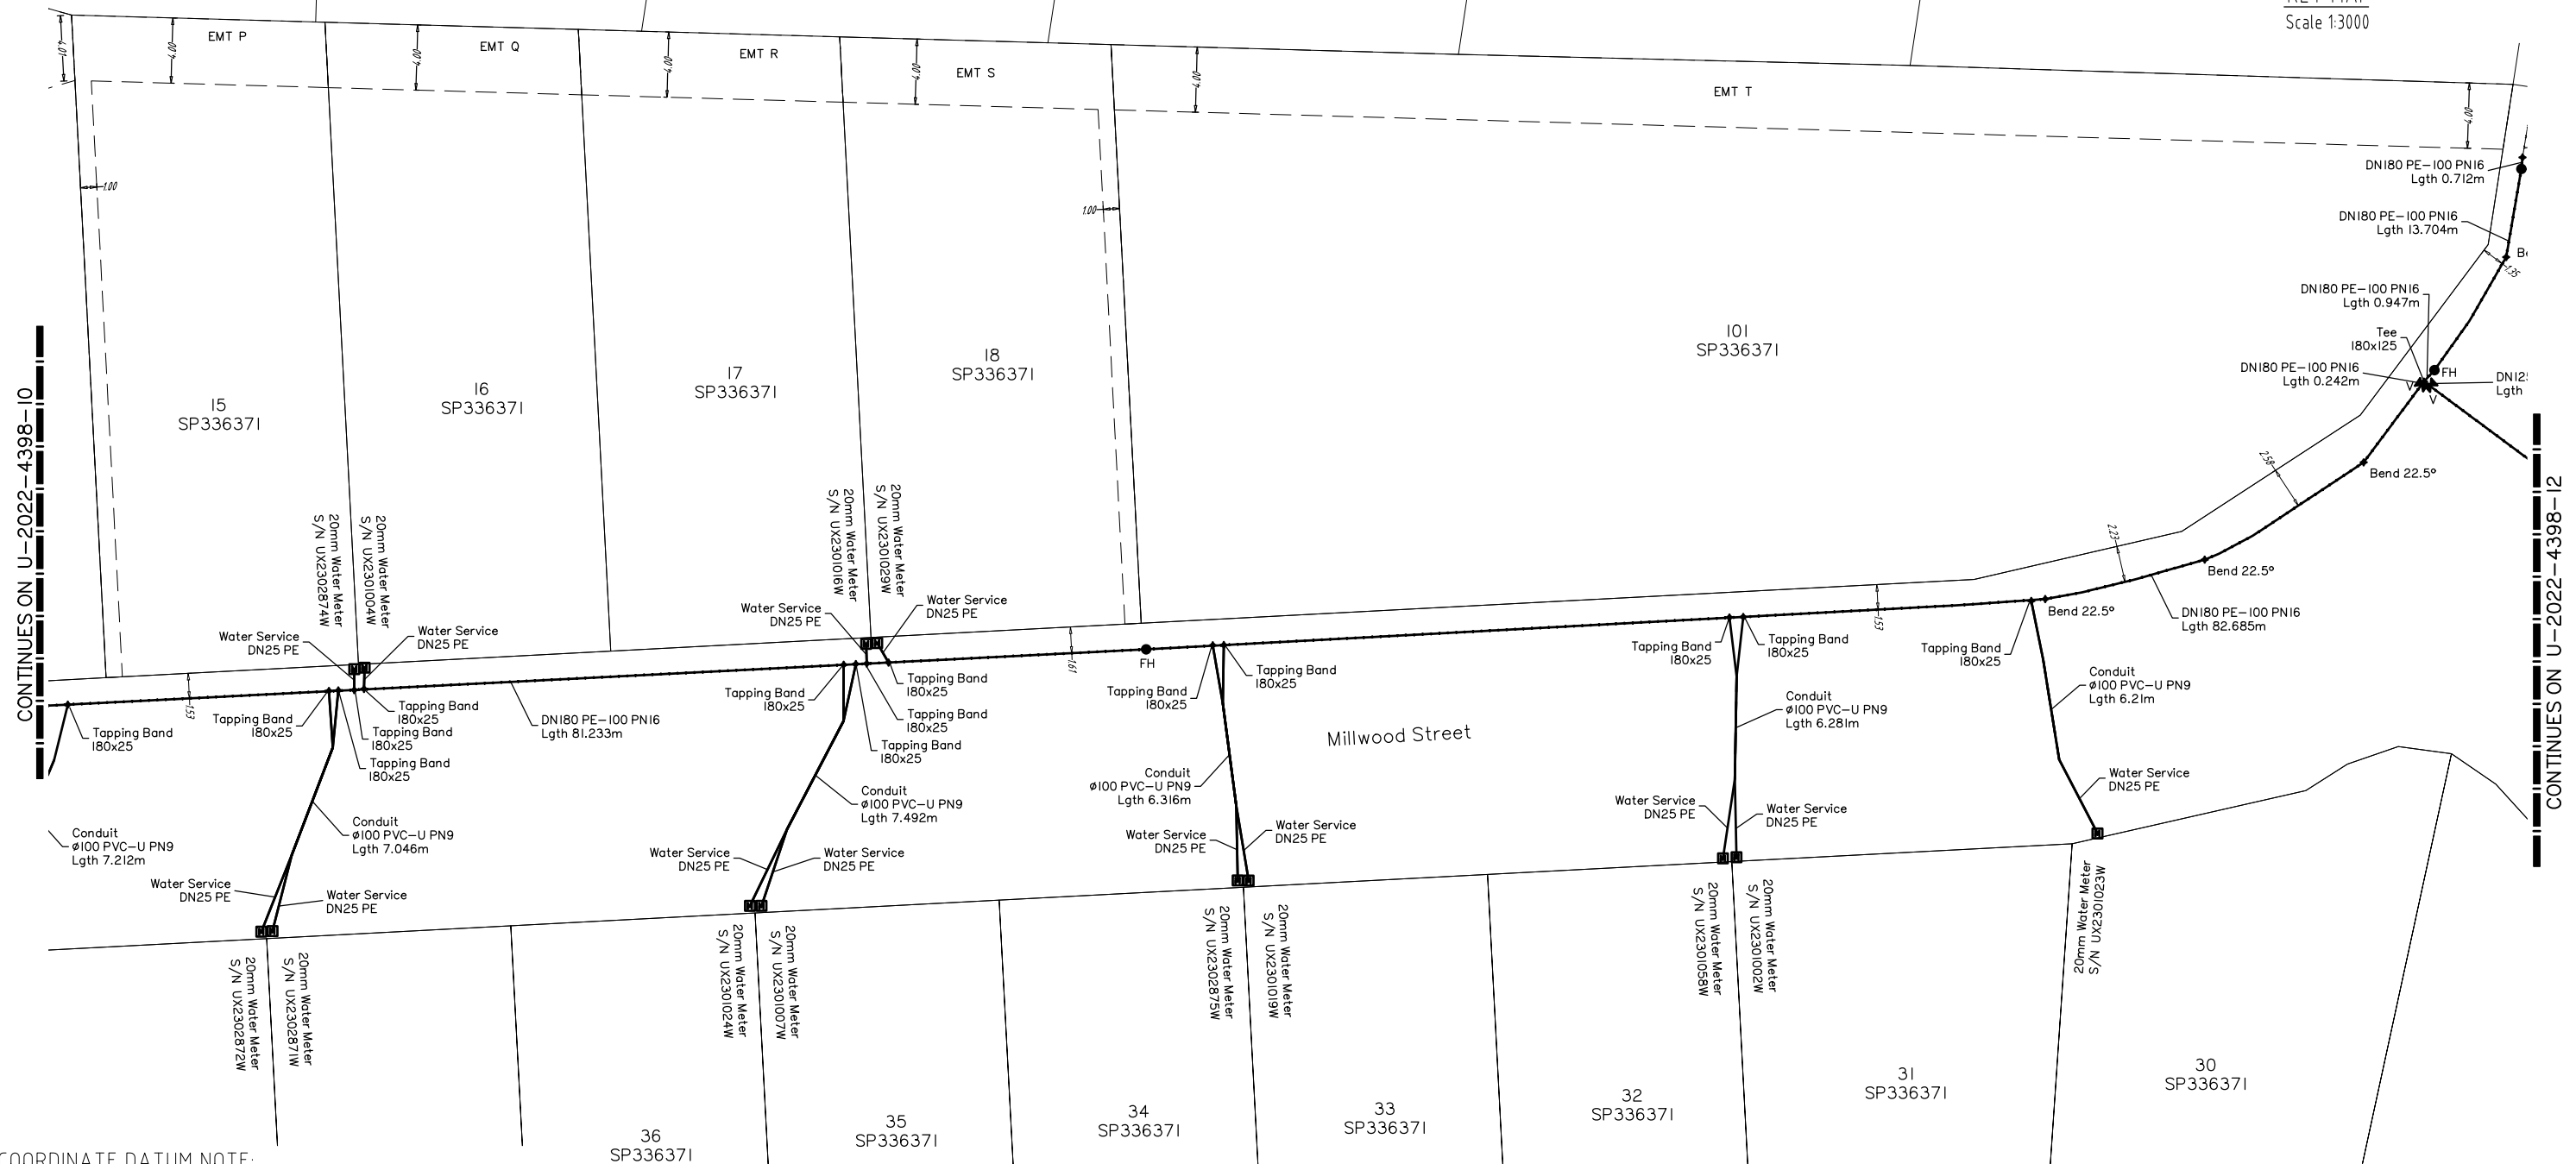

CONTINUES ON U-2022-4398-10

CONTINUES ON U-2022-4398-12



COORDINATE DATUM NOTE:
HORIZONTAL COORDINATES(E,N) SUPPLIED ARE MAPPING GRID OF AUSTRALIA(MGA), ZONE 56 BASED ON THE UNIVERSAL TRANSVERSE MERCATOR PROJECTION AND THE GEOCENTRIC DATUM OF AUSTRALIA 2020.

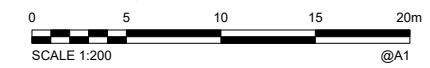

AS CONSTRUCTED

A1						<small>urban planning, surveying & development</small> Brisbane PO Box 3126, West End QLD 4101 Ph: 3118 0000 Machay PO Box 11711, Mackay Queensland QLD 4740 Ph: 3302 278 Fax: 3302 278 brisbane@dtsd.com.au machay@dtsd.com.au			Unitywater 201801246750 STAGES 1-4 41 GLENBROOK DRIVE, NAMBOUR AS CONSTRUCTED WATER	SHEET 11 OF 14 SHEETS REVISION DATE 19-02-2024 DISCIPLINE CODE C DRAWING NO. U-2022-4398-11	SCALE 1:200 REVISION A
	DRAWN AA 19-02-2024	CHECKED SW 19-02-2024	PASSED	INITIALS DATE	INDEX DATE REVISIONS					DRAWN CHECKED PASSED	

PSM105139
 E: 494333.800
 N: 7056051.090
 RL: 68.200m

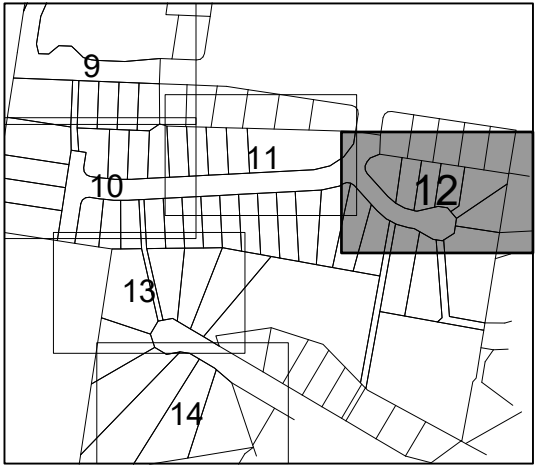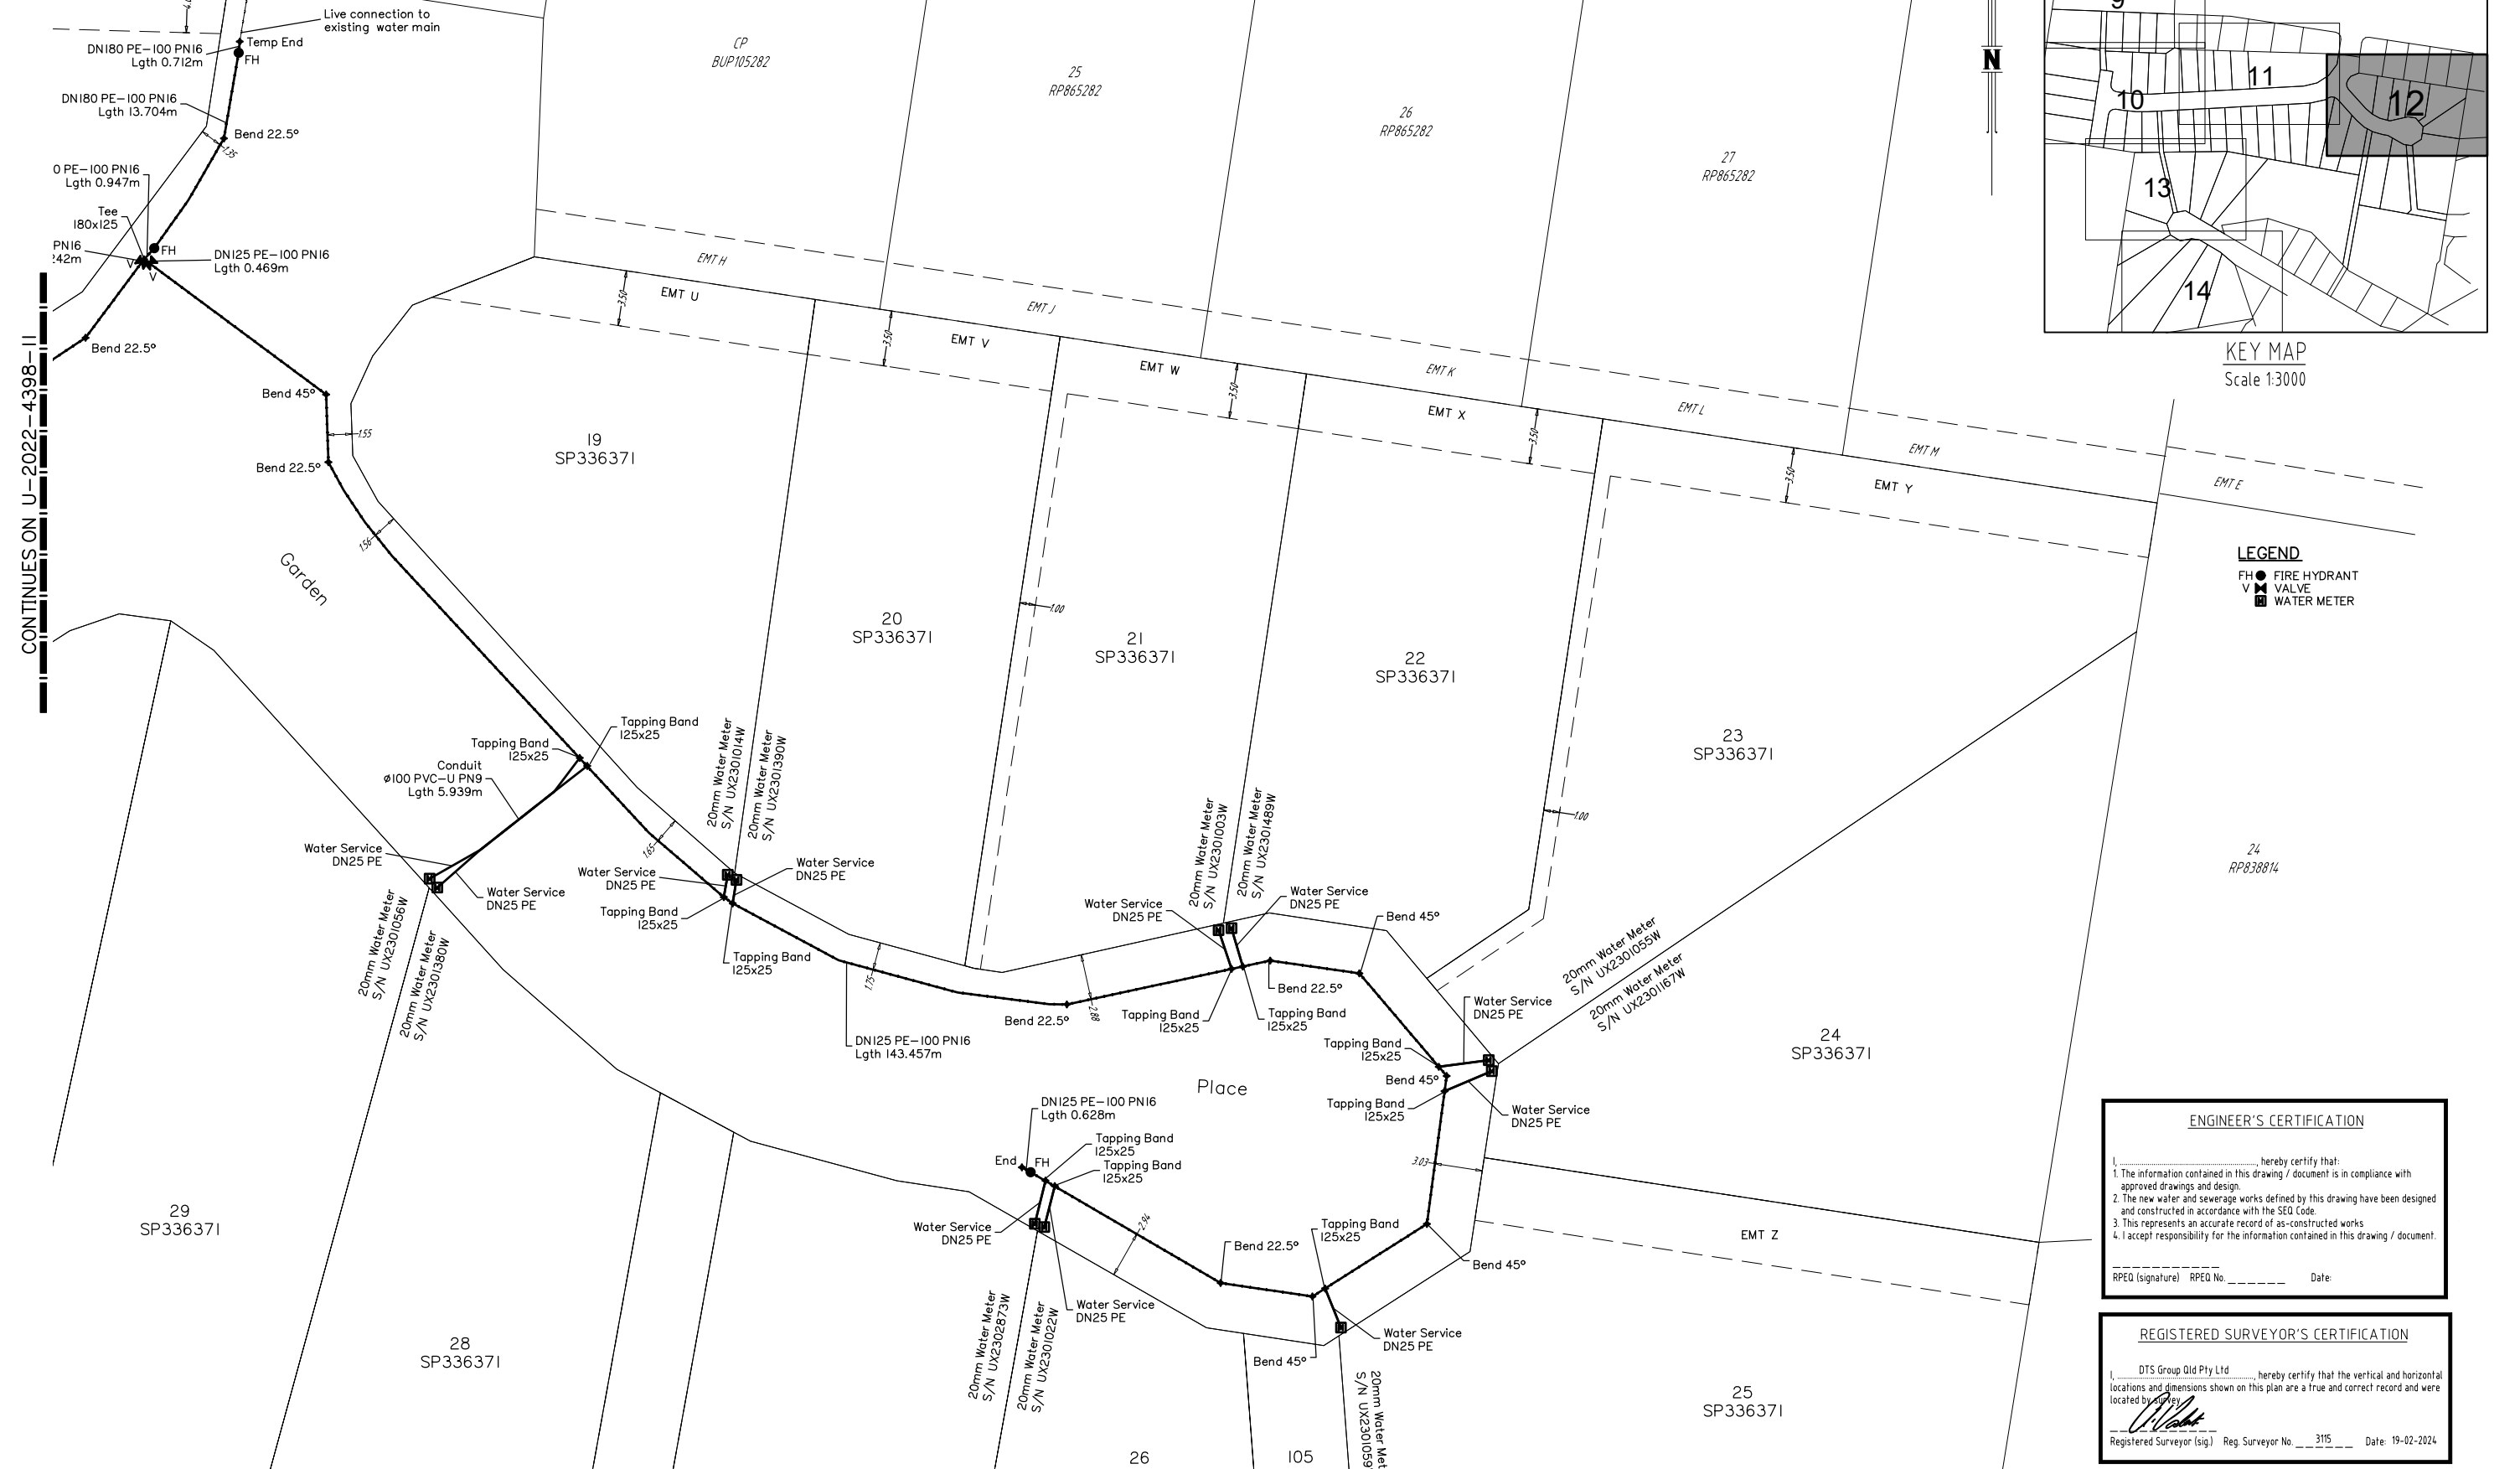


KEY MAP
 Scale 1:3000

LEGEND
 FH ● FIRE HYDRANT
 V ■ VALVE
 W ■ WATER METER

ENGINEER'S CERTIFICATION
 I, _____, hereby certify that:
 1. The information contained in this drawing / document is in compliance with approved drawings and design.
 2. The new water and sewerage works defined by this drawing have been designed and constructed in accordance with the SEQ Code.
 3. This represents an accurate record of as-constructed works
 4. I accept responsibility for the information contained in this drawing / document.
 RPEQ (signature) RPEQ No. _____ Date: _____

REGISTERED SURVEYOR'S CERTIFICATION
 I, DTS Group Qld Pty Ltd, hereby certify that the vertical and horizontal locations and dimensions shown on this plan are a true and correct record and were located by _____
 Registered Surveyor (sig) Reg. Surveyor No. 3115 Date: 19-02-2024

COORDINATE DATUM NOTE:
 HORIZONTAL COORDINATES(E,N) SUPPLIED ARE MAPPING GRID OF AUSTRALIA(MGA), ZONE 56 BASED ON THE UNIVERSAL TRANSVERSE MERCATOR PROJECTION AND THE GEOCENTRIC DATUM OF AUSTRALIA 2020.

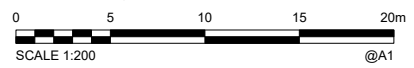

AS CONSTRUCTED


A1									
	INDEX	DATE	REVISIONS	DRAWN	CHECKED	PASSED	INITIALS	DATE	
	19-02-2024	FINAL AS CONSTRUCTED	AA	SW					

DRAWN	AA	19-02-2024
CHECKED	SW	19-02-2024
PASSED		



Unitywater
 201801246750
 STAGES 1-4
 41 GLENBROOK DRIVE, NAMBOUR
 AS CONSTRUCTED WATER

SHEET 12 OF 14 SHEETS	SCALE 1:200
REVISION DATE 19-02-2024	REVISION A
DISCIPLINE CODE C	
DRAWING NO. U-2022-4398-12	

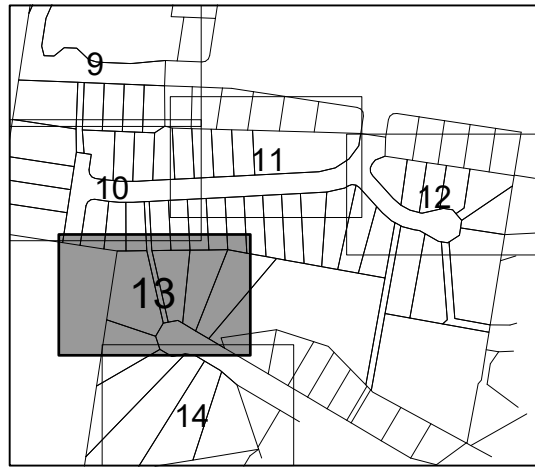

KEY MAP
Scale 1:3000

LEGEND

- FH ● FIRE HYDRANT
- V ▽ VALVE
- WATER METER

4
RP188606

ENGINEER'S CERTIFICATION

- I, _____ hereby certify that:
- The information contained in this drawing / document is in compliance with approved drawings and design.
 - The new water and sewerage works defined by this drawing have been designed and constructed in accordance with the SEQ Code.
 - This represents an accurate record of as-constructed works.
 - I accept responsibility for the information contained in this drawing / document.

RPEQ (signature) RPEQ No. _____ Date: _____


REGISTERED SURVEYOR'S CERTIFICATION

I, DTS Group Qld Pty Ltd, hereby certify that the vertical and horizontal locations and dimensions shown on this plan are a true and correct record and were located by survey.

Registered Surveyor (sig) _____ Reg. Surveyor No. 3115 Date: 19-02-2024


PSM105139
E: 494.333.800
N: 7056051.090
RL: 68.200m

CONTINUES ON U-2022-4398-10

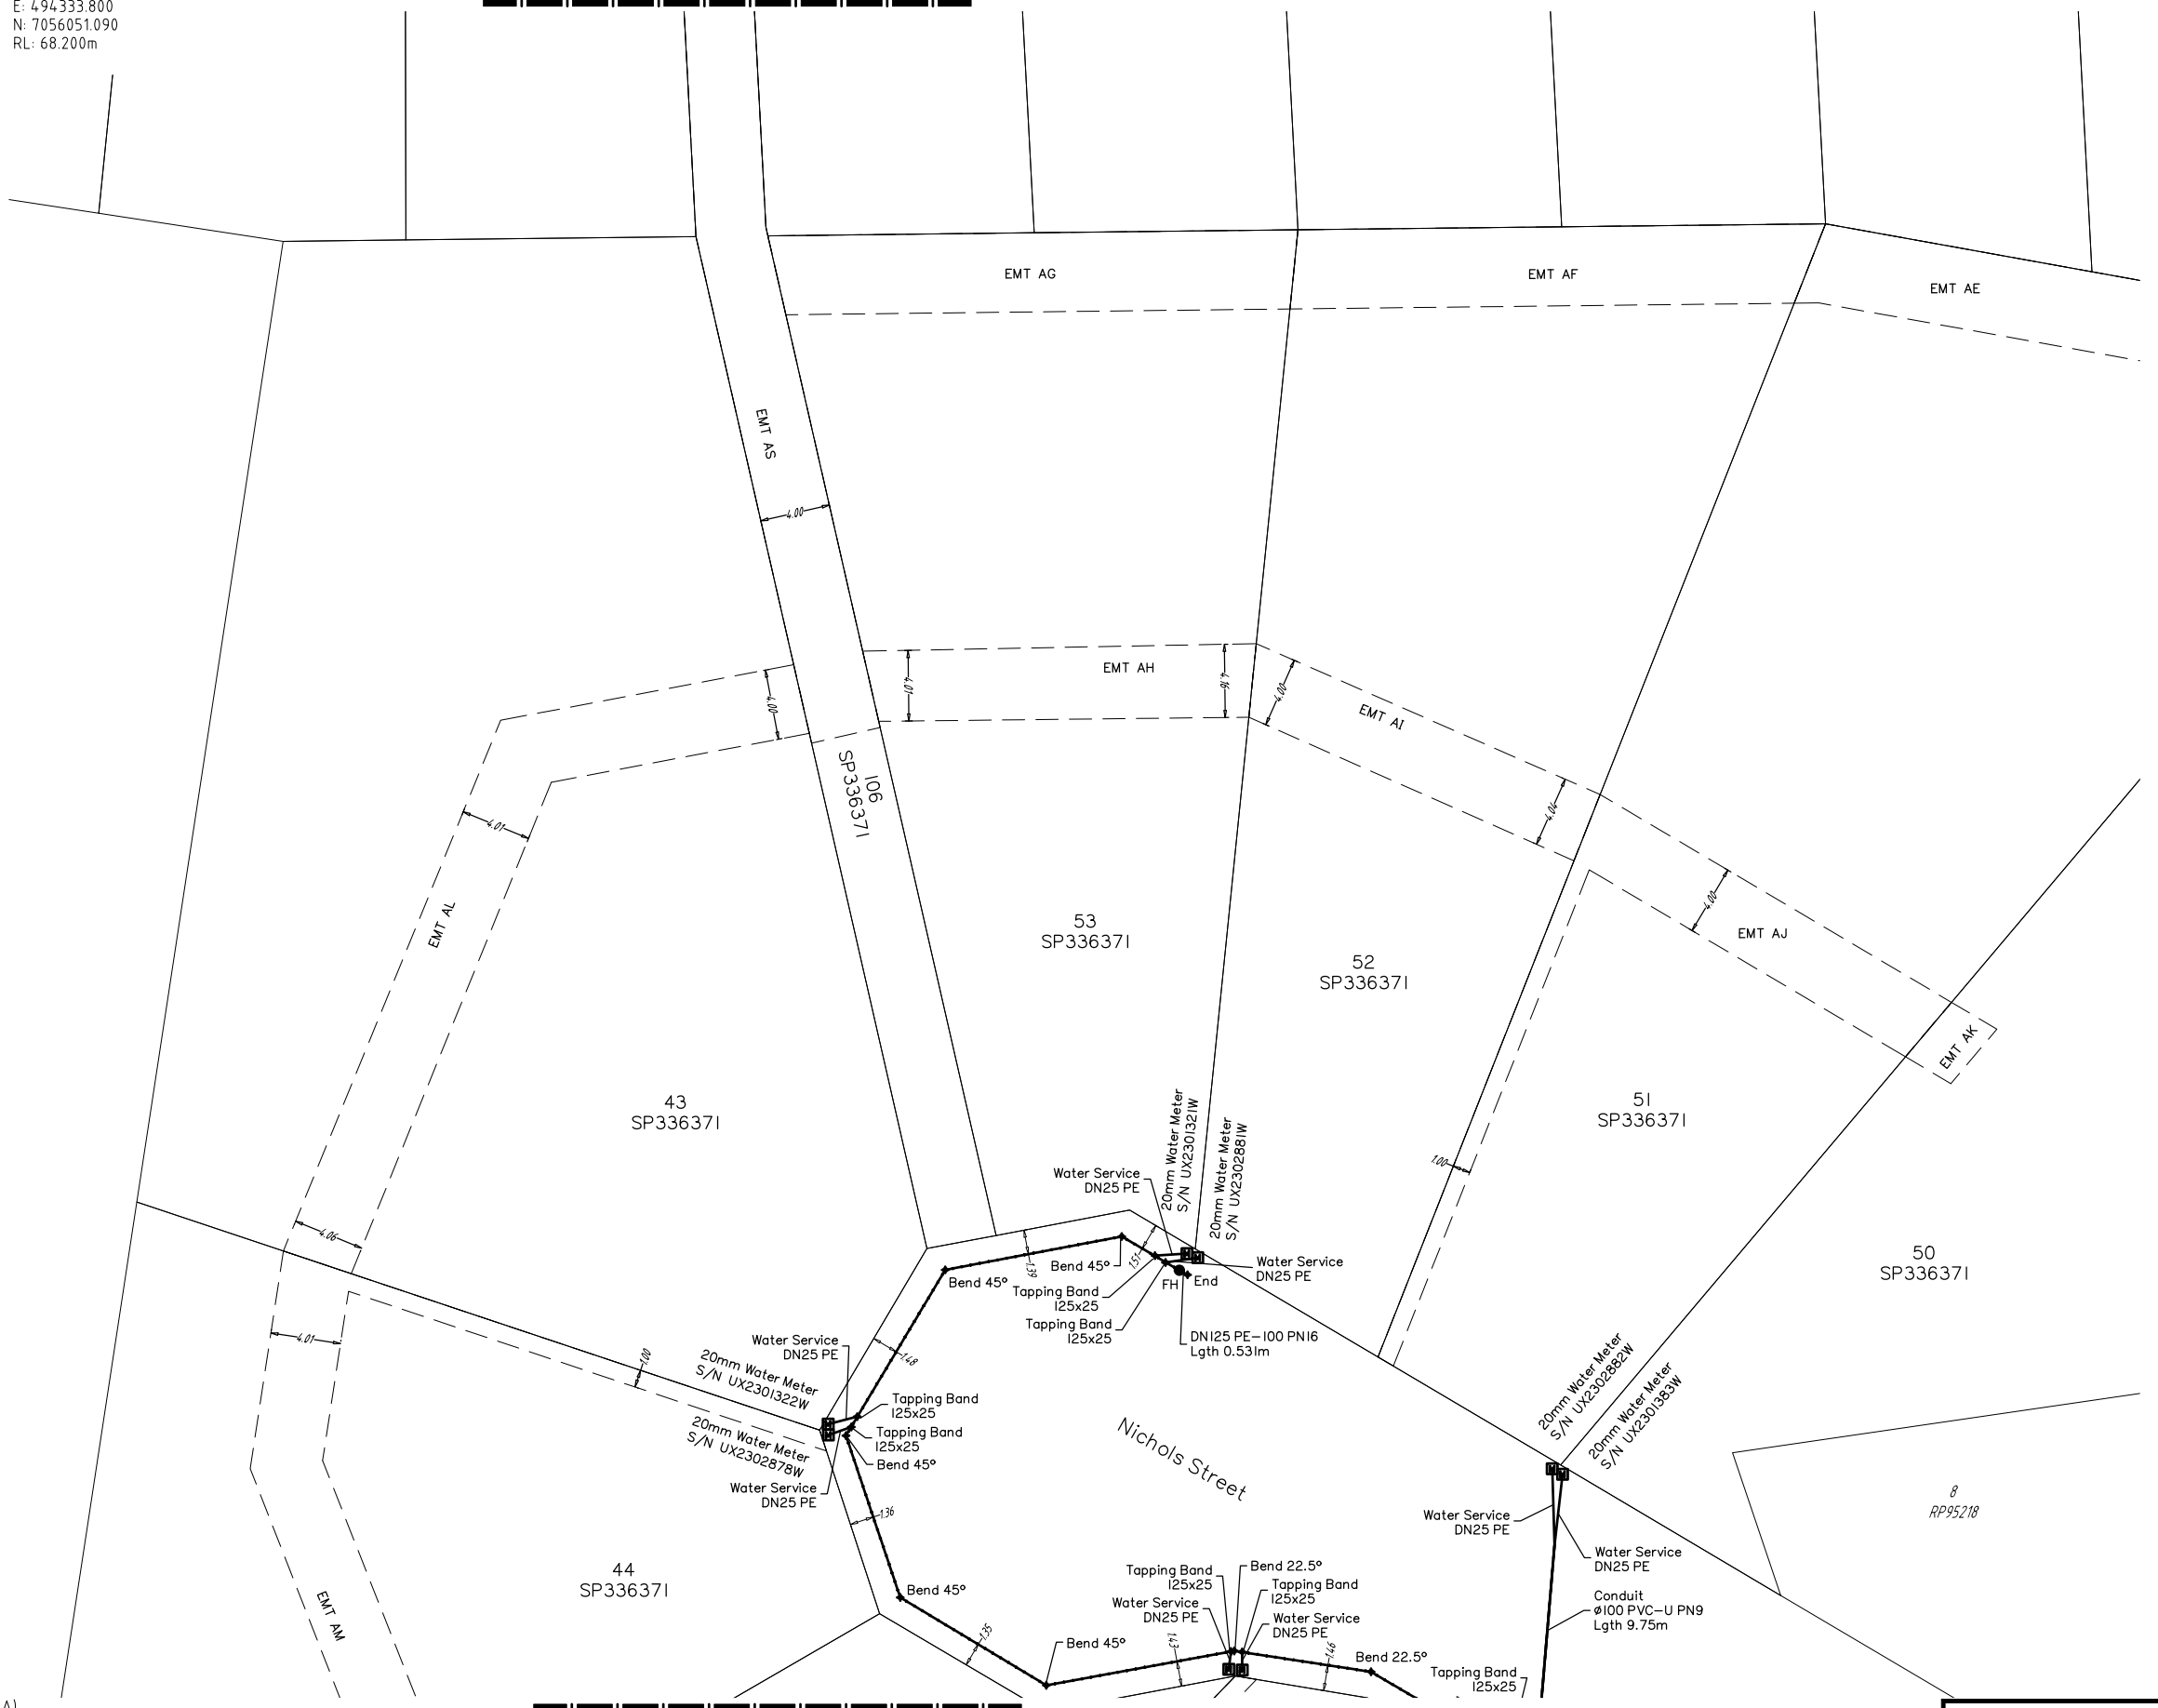

CONTINUES ON U-2022-4398-14

COORDINATE DATUM NOTE:
HORIZONTAL COORDINATES(E,N) SUPPLIED ARE MAPPING GRID OF AUSTRALIA(MGA), ZONE 56 BASED ON THE UNIVERSAL TRANSVERSE MERCATOR PROJECTION AND THE GEOCENTRIC DATUM OF AUSTRALIA 2020.

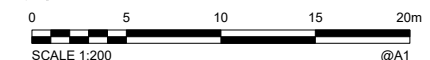

AS CONSTRUCTED

A1

INDEX	DATE	REVISIONS	DRAWN	CHECKED	PASSED	INITIALS	DATE
A	19-02-2024	FINAL AS CONSTRUCTED	AA	SW			

DRAWN	AA	19-02-2024
CHECKED	SW	19-02-2024
PASSED		



Unitywater

201801246750
STAGES 1-4
41 GLENBROOK DRIVE, NAMBOUR
AS CONSTRUCTED WATER

SHEET 13 OF 14	SHEETS	SCALE 1:200
REVISION DATE	19-02-2024	REVISION A
DISCIPLINE CODE	C	
DRAWING NO.	U-2022-4398-13	

PSM105139
 E: 494333.800
 N: 7056051.090
 RL: 68.200m

CONTINUES ON U-2022-4398-13

44
 SP336371

45
 SP336371

46
 SP336371

47
 SP336371

48
 SP336371

42
 RP143819

7
 RP95218

6
 RP95218



KEY MAP
 Scale 1:3000

LEGEND

- FH FIRE HYDRANT
- V VALVE
- WATER METER

ENGINEER'S CERTIFICATION

I, _____, hereby certify that:
 1. The information contained in this drawing / document is in compliance with approved drawings and design.
 2. The new water and sewerage works defined by this drawing have been designed and constructed in accordance with the SEQ Code.
 3. This represents an accurate record of as-constructed works.
 4. I accept responsibility for the information contained in this drawing / document.


RPEO (signature) RPEO No. _____ Date: _____

REGISTERED SURVEYOR'S CERTIFICATION

I, DTS Group Old Pty Ltd, hereby certify that the vertical and horizontal locations and dimensions shown on this plan are a true and correct record and were located by survey.

[Signature]
 Registered Surveyor (sig) Reg. Surveyor No. 3115 Date: 19-02-2024

COORDINATE DATUM NOTE:
 HORIZONTAL COORDINATES(E,N) SUPPLIED ARE MAPPING GRID OF AUSTRALIA(MGA), ZONE 56 BASED ON THE UNIVERSAL TRANSVERSE MERCATOR PROJECTION AND THE GEOCENTRIC DATUM OF AUSTRALIA 2020.

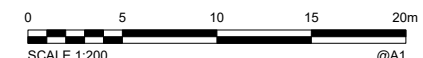


AS CONSTRUCTED

A1

INDEX	DATE	REVISIONS	DRAWN	CHECKED	PASSED
A	19-02-2024	FINAL AS CONSTRUCTED	AA	SW	

DRAWN	CHECKED	PASSED	INITIALS	DATE
AA	SW			19-02-2024

dts urban planning, surveying & development
 Brisbane PO Box 3126, West End QLD 4101 Ph: 07 3118 0000
 Machay PO Box 11711, Mackay Queensland QLD 4740 Ph: 1300 278 788

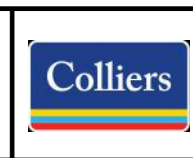

Unitywater
 201801246750
 STAGES 1-4
 41 GLENBROOK DRIVE, NAMBOUR
 AS CONSTRUCTED WATER

SHEET 14 OF 14 SHEETS	SCALE 1:200
REVISION DATE 19-02-2024	REVISION A
DISCIPLINE CODE C	
DRAWING NO. U-2022-4398-14	